EXHIBIT "A" ZC#23-025

Legal Description

BEING 3.382 acres (147,308 square feet) of land in the Henry McGehee Survey, Abstract No. 998, City of Mansfield, Tarrant County, Texas; said 3.382 acres (147,308 square feet) of land being a portion of that certain tract of land described in a Warranty Deed to Ira T. Kimbrough and Andrea E. Kimbrough (hereinafter referred to as Kimbrough tract), as recorded in Volume 6296, Page 991, Deed Records, Tarrant County, Texas (D.R.T.C.T.); said 3.382 acres (147,308 square feet) of land being more particularly described, by metes and bounds, as follows:

BEGINNING at a five-eighths inch iron rod with plastic cap stamped "RPLS 4838" found for the Northeast corner of the remainder of said Kimbrough tract, same being the Southeast corner of that certain tract of land described as Lot 1, Block 1, JaRy Co. Addition (hereinafter referred to as Lot 1), an addition to the City of Mansfield, Tarrant County, Texas, according to the plat recorded in Instrument Number D222225973, Official Public Records, Tarrant County, Texas (O.P.R.T.C.T.), same also being the existing Southwesterly right-of-way line of North Walnut Creek Drive (90' right-of-way), as recorded in Volume 388-203, Page 20, Plat Records, Tarrant County, Texas (P.R.T.C.T.);

THENCE South 30 degrees 24 minutes 14 seconds East with the common line between the remainder of said Kimbrough tract and the existing Southwesterly right-of-way line of said North Walnut Creek Drive, a distance of 230.60 feet to a five-eighths inch iron rod with plastic cap stamped "RPLS 4838" found for corner;

THENCE South 14 degrees 26 minutes 55 seconds East, continue with the common line between the remainder of said Kimbrough tract and the existing Southwesterly right-of-way line of said North Walnut Creek Drive, a distance of 40.00 feet to a five-eighths inch iron rod with plastic cap stamped "RPLS 4838" found for corner, same being the beginning of a non-tangent curve to the right, whose long chord bears South 14 degrees 34 minutes 49 seconds West, a distance of 96.14 feet;


THENCE Southerly, continue with the common line between the remainder of said Kimbrough tract and the existing Southwesterly right-of-way line of said North Walnut Creek Drive, with said non-tangent curve to the right, having a radius of 68.00 feet, through a central angle of 89 degrees 57 minutes 52 seconds, for an arc distance of 106.77 feet to a five-eighths inch iron rod with plastic cap stamped "RPLS 4838" found for the intersection of the existing Southwesterly right-of-way line of said North Walnut Creek Drive with the existing Northwesterly right-of-way line of East Debbie Lane (variable width right-of-way), as recorded in Instrument Number D201101824, O.P.R.T.C.T.;

THENCE South 59 degrees 33 minutes 38 seconds West with the common line between the remainder of said Kimbrough tract and the existing Northwesterly right-of-way line of said East Debbie Lane, a distance of 364.08 feet to a five-eighths inch iron rod with plastic cap stamped "RPLS 4838" found for corner;

THENCE North 30 degrees 20 minutes 22 seconds West, departing the existing Northwesterly right-of-way line of said East Debbie Lane, with the Southwesterly line of said Kimbrough tract, a distance of 337.07 feet to a five-eighths inch iron rod with plastic cap stamped "RPLS 4838" found for the Northwesterly corner of the remainder of said Kimbrough tract, same also being the Southwesterly corner of the aforesaid Lot 1;

THENCE North 59 degrees 34 minutes 07 seconds East with the common line between the remainder of said Kimbrough tract and said Lot 1, a distance of 442.66 feet to the place of beginning, and containing a calculated area of 3.382 acres (147,308 square feet) of land.

NOTE: The Company is prohibited from insuring the area or quantity of the land described herein. Any statement in the legal description contained in Schedule "A" as to area or quantity of land is not a representation that such area or quantity is correct, but is made only for informal identification purposes and does not override Item 2 of Schedule "B" hereof.

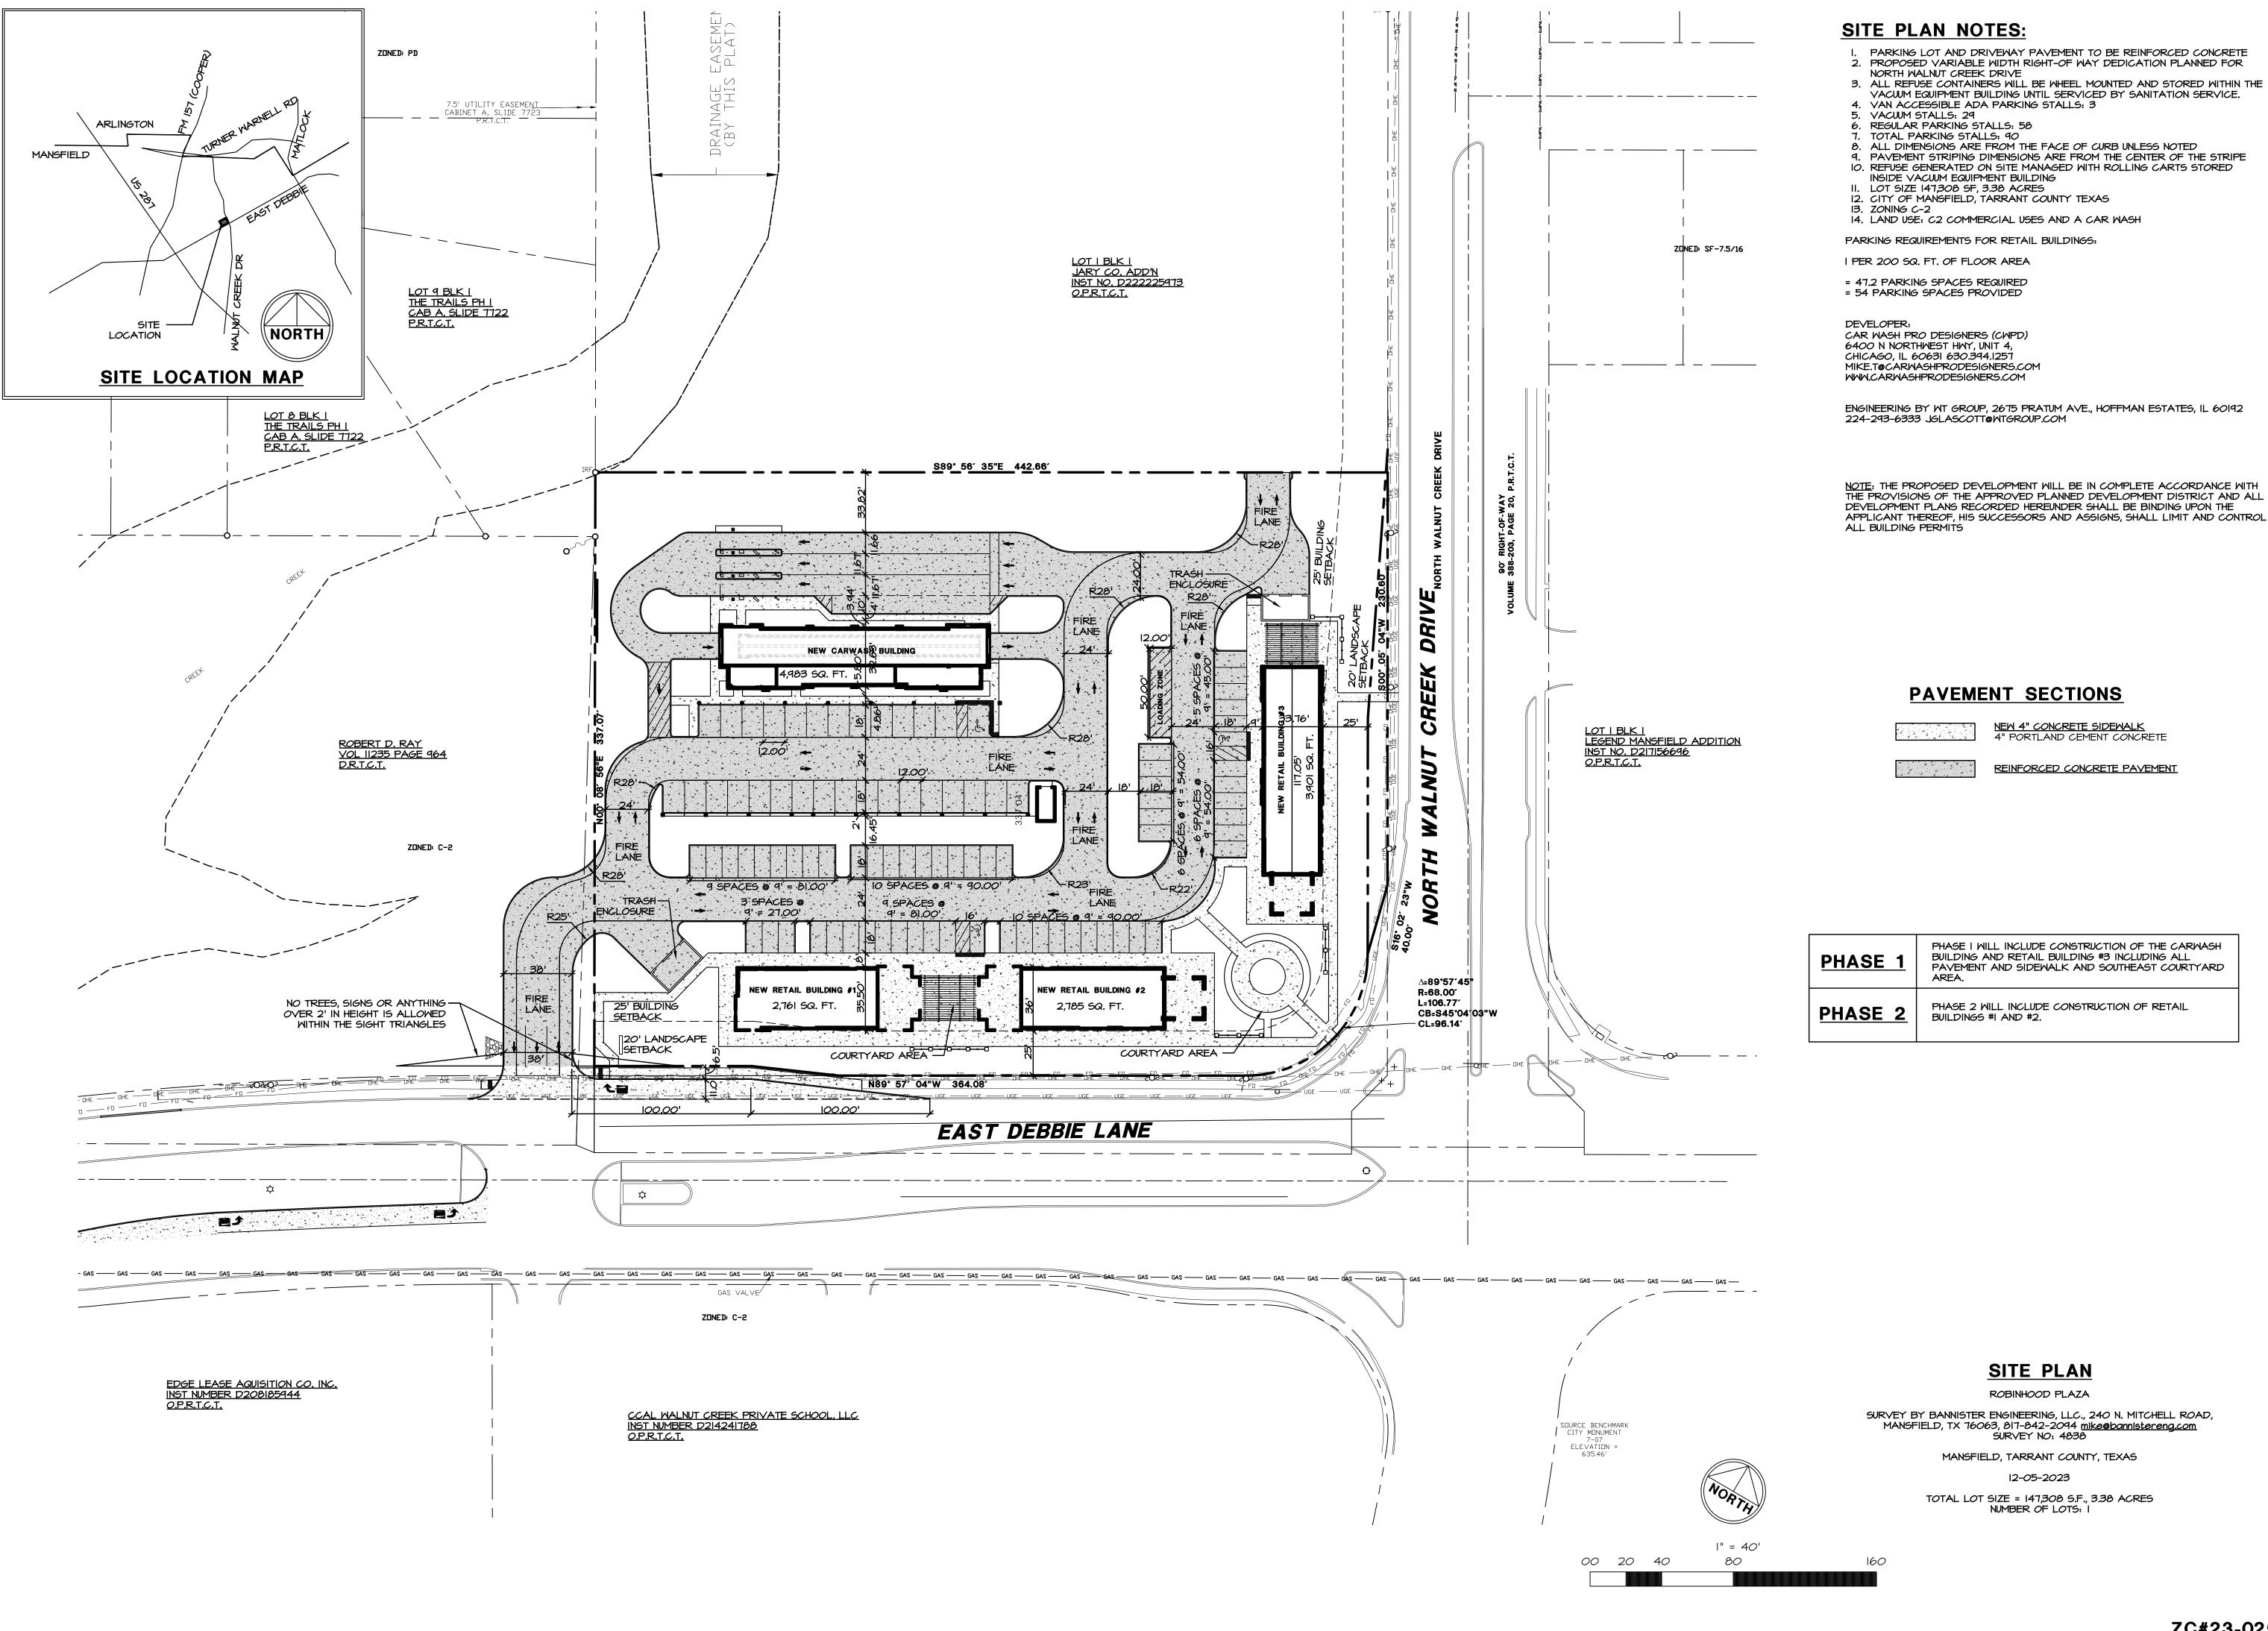

DRAWN:TEP JOB: C2300027

CHECK:TOA

10/18/23 12/14/23

0

PERMIT

THIS DOCUMENT IS RELEASED

THE AUTHORITY OF TODD ABRAMS, PE

RELEASED FOR REVIEW NOT FOR CONSTRUCTION. TODD ABRAMS, PE TEXAS PE 126182

> TEXAS FIRM ID NO. 18685


WASH F/ E. DEBBIE I ANSFIELD, T

FOR THE PURPOSE OF PRELIMINARY REVIEW UNDER

EX-B

ZC#23-025

EXHIBIT B

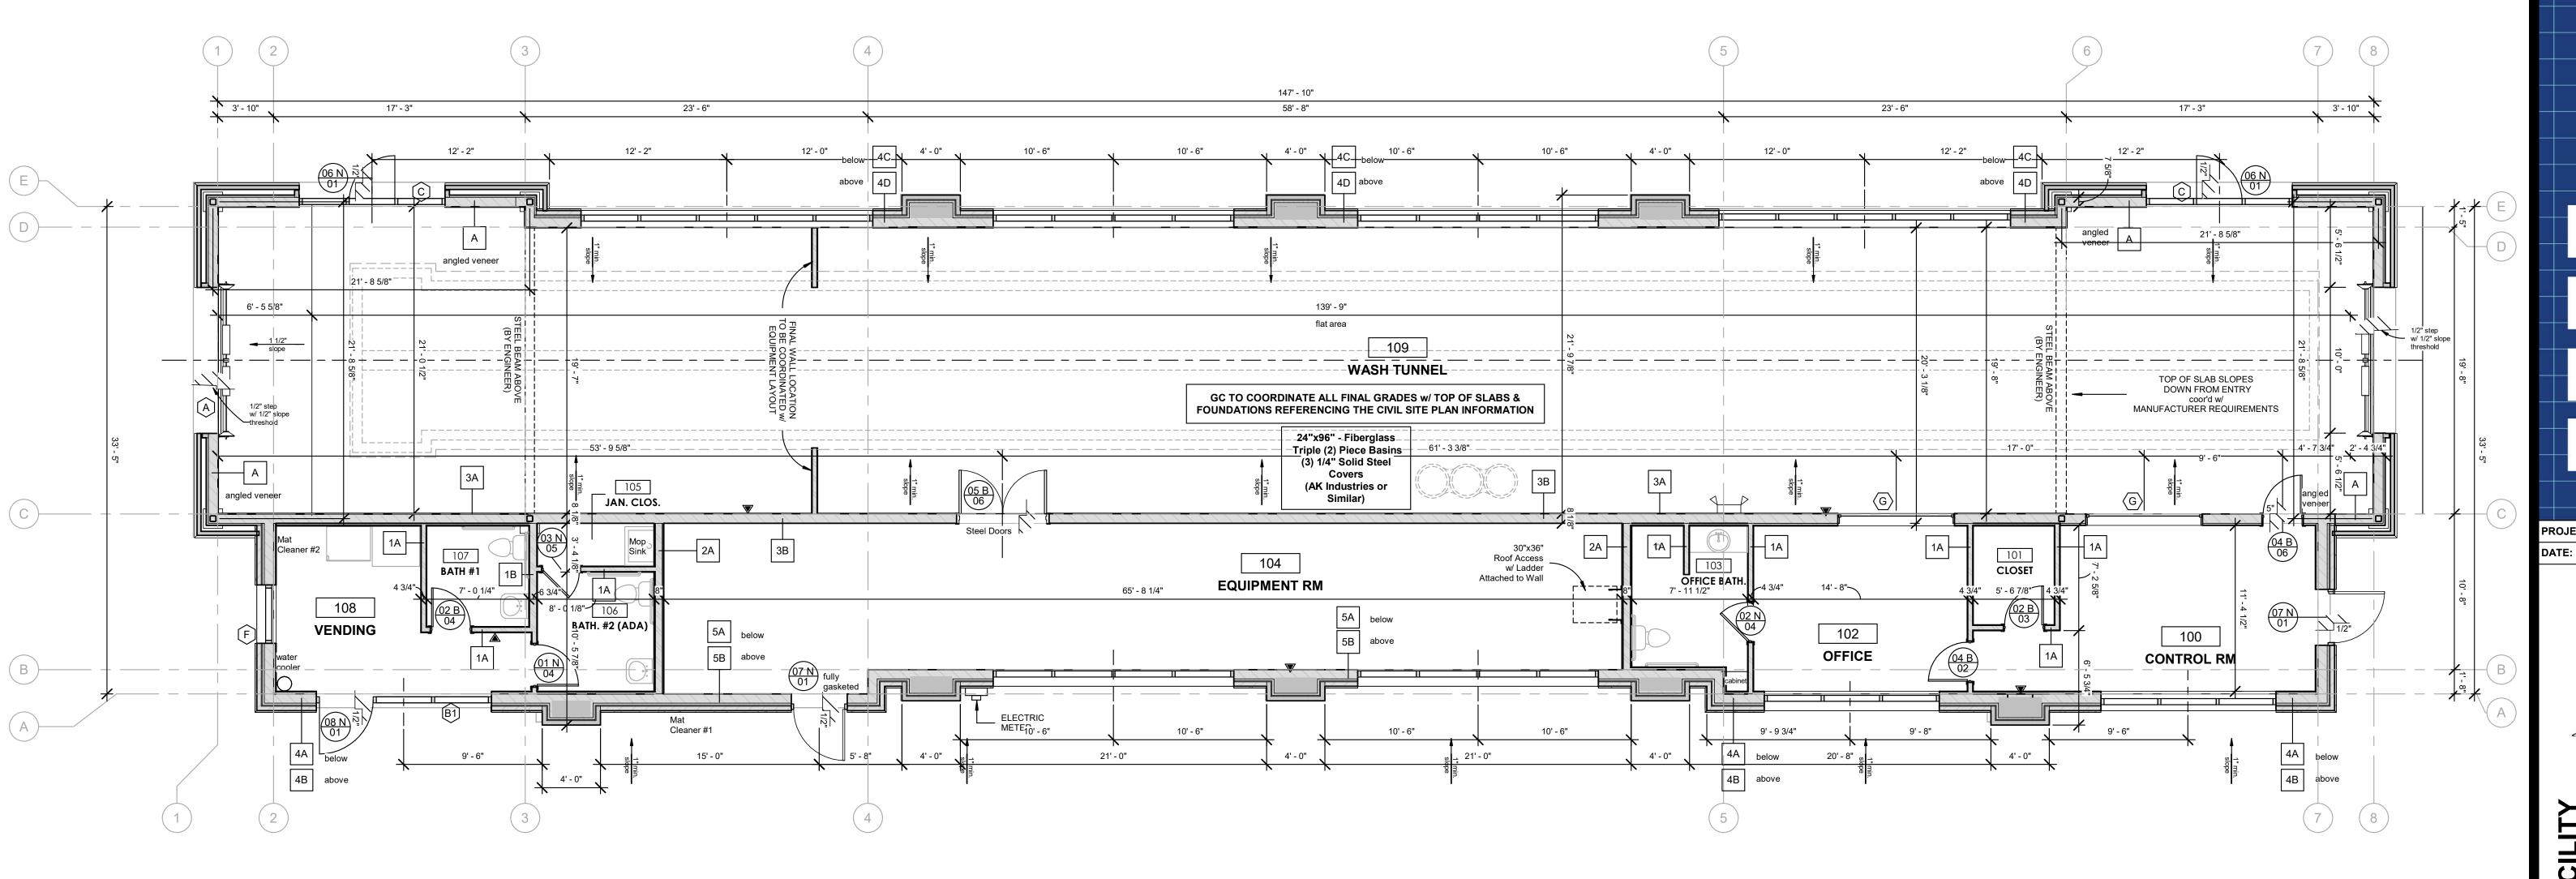

CAR WASH FIRST FLOOR PLAN

SCALE: 3/16" = 1'-0"



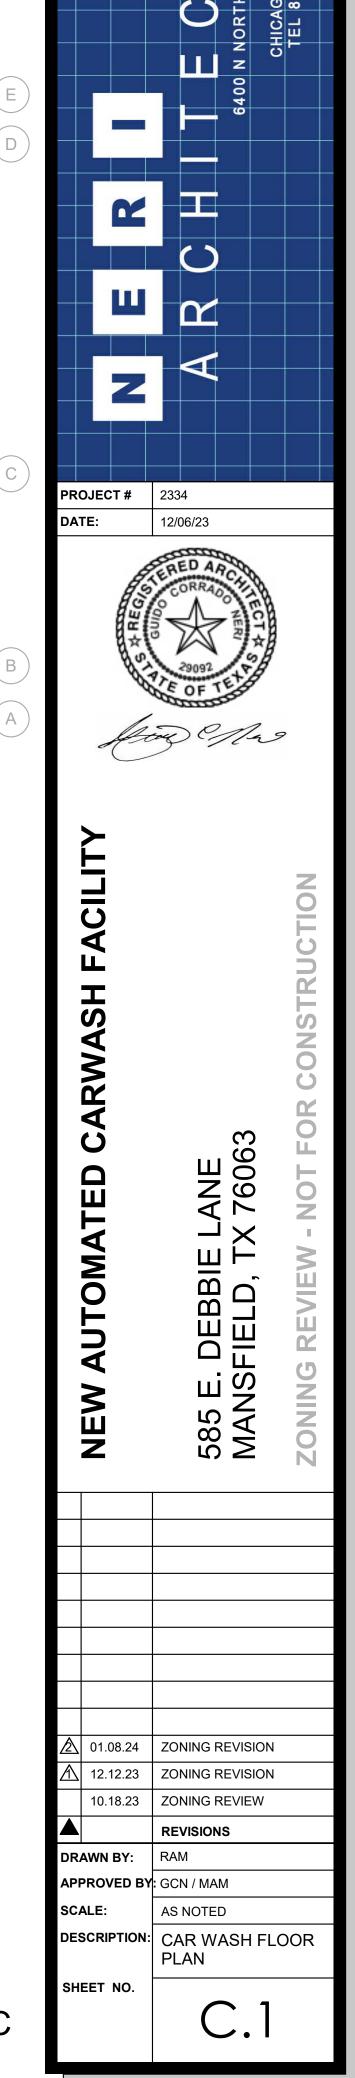



Exhibit C



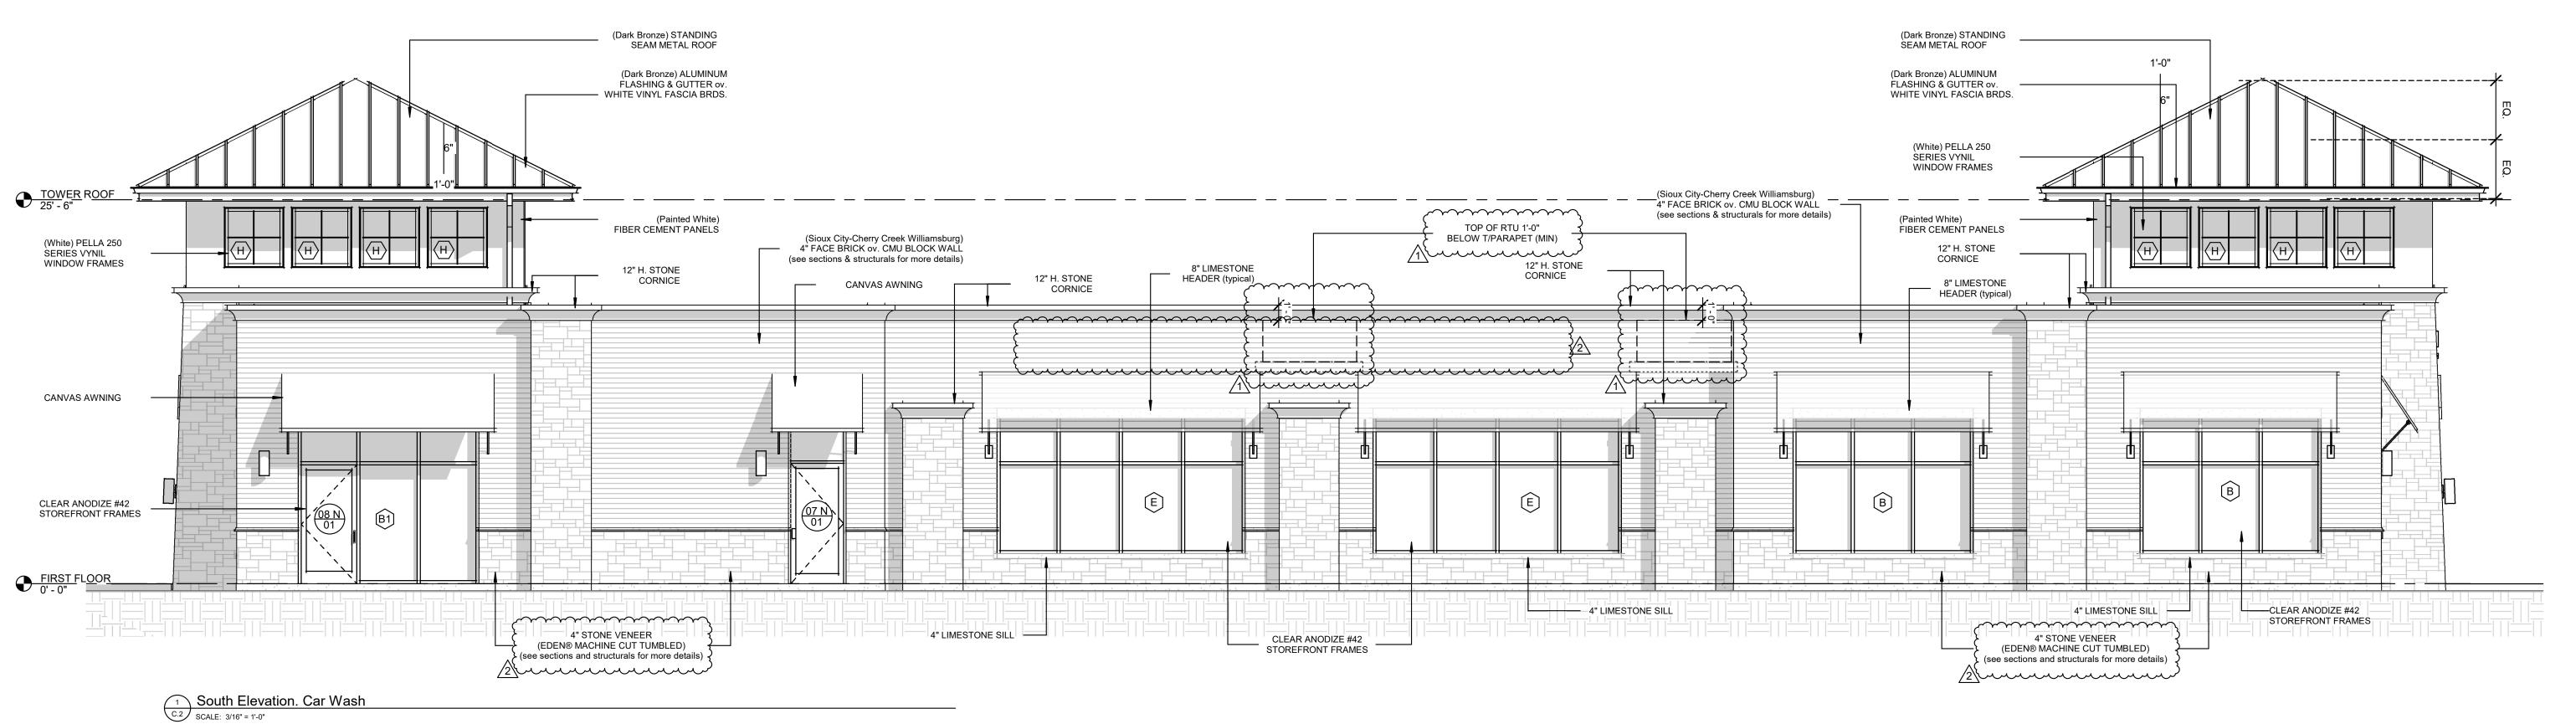


North Elevation. Car Wash
SCALE: 3/16" = 1"-0"

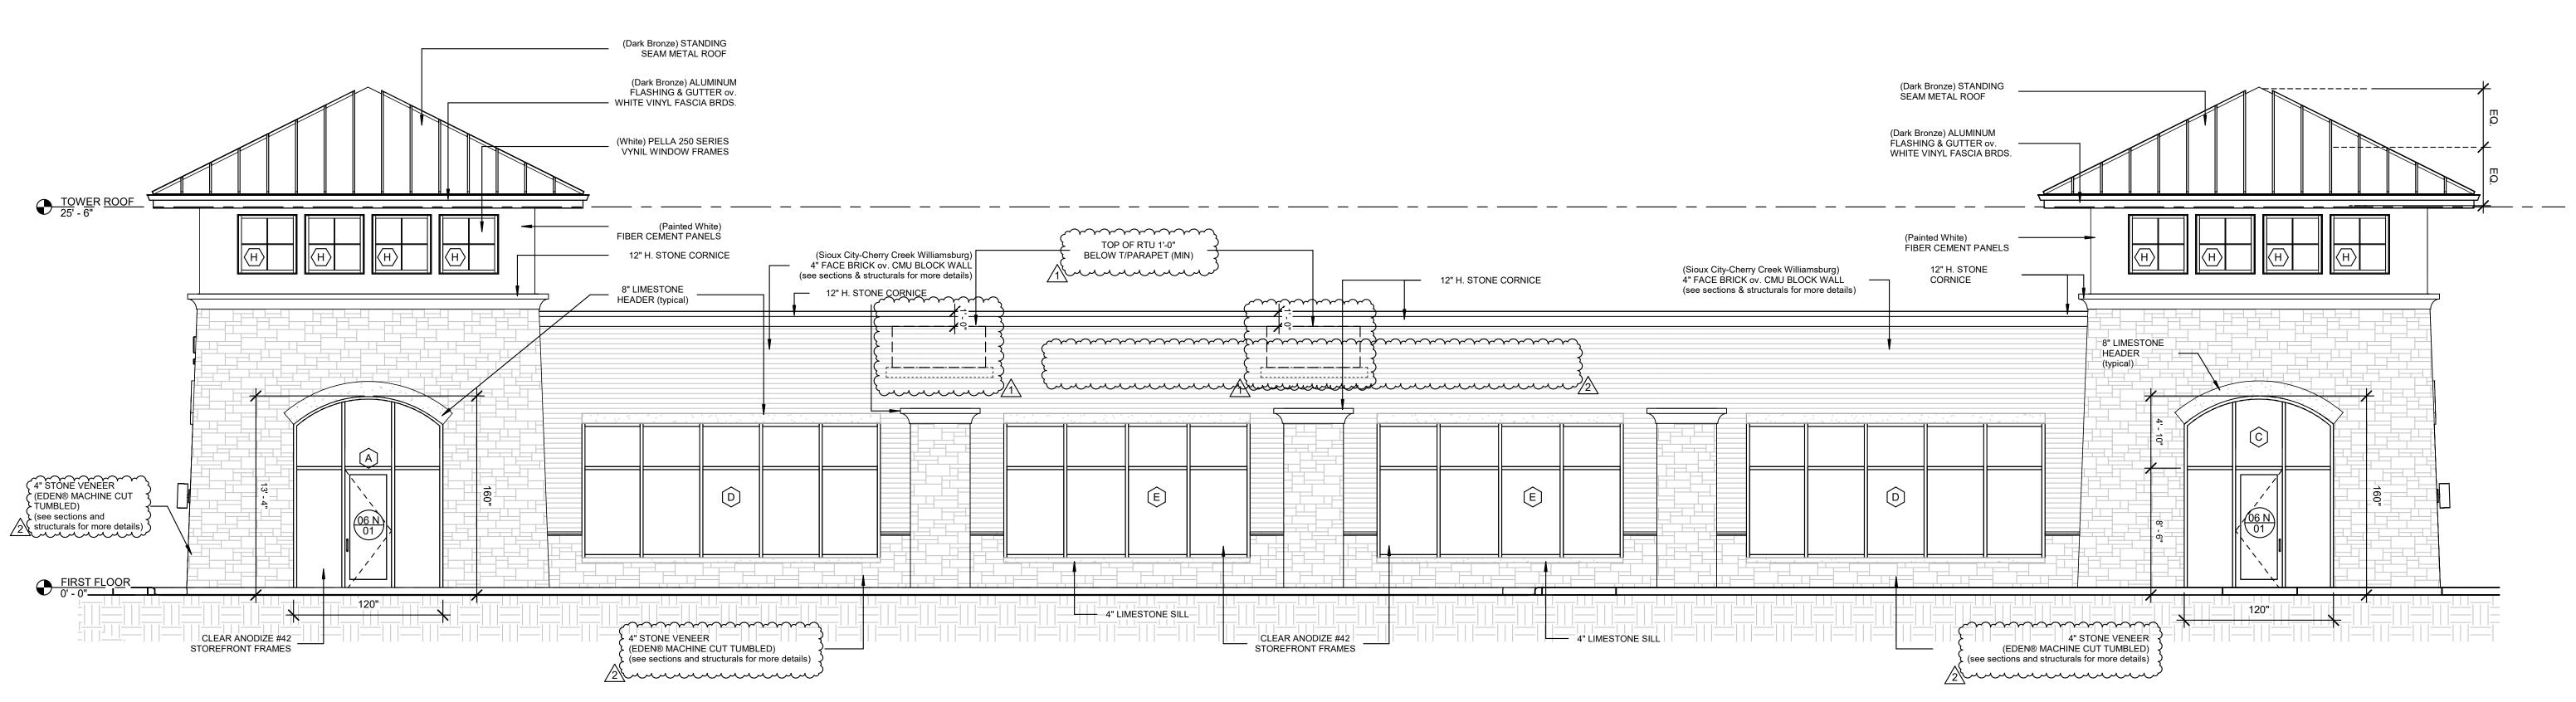

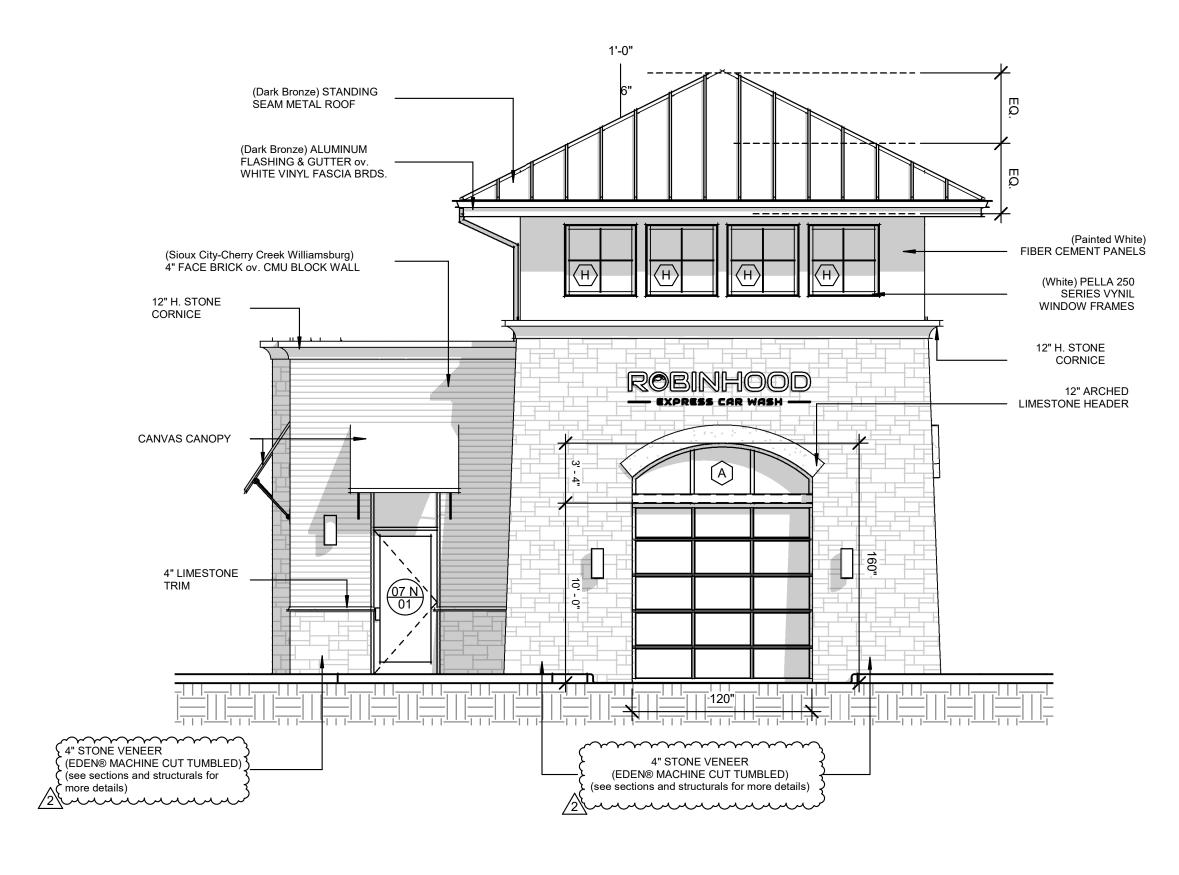

East Elevation. Car Wash

SCALE: 3/16" = 1'-0"

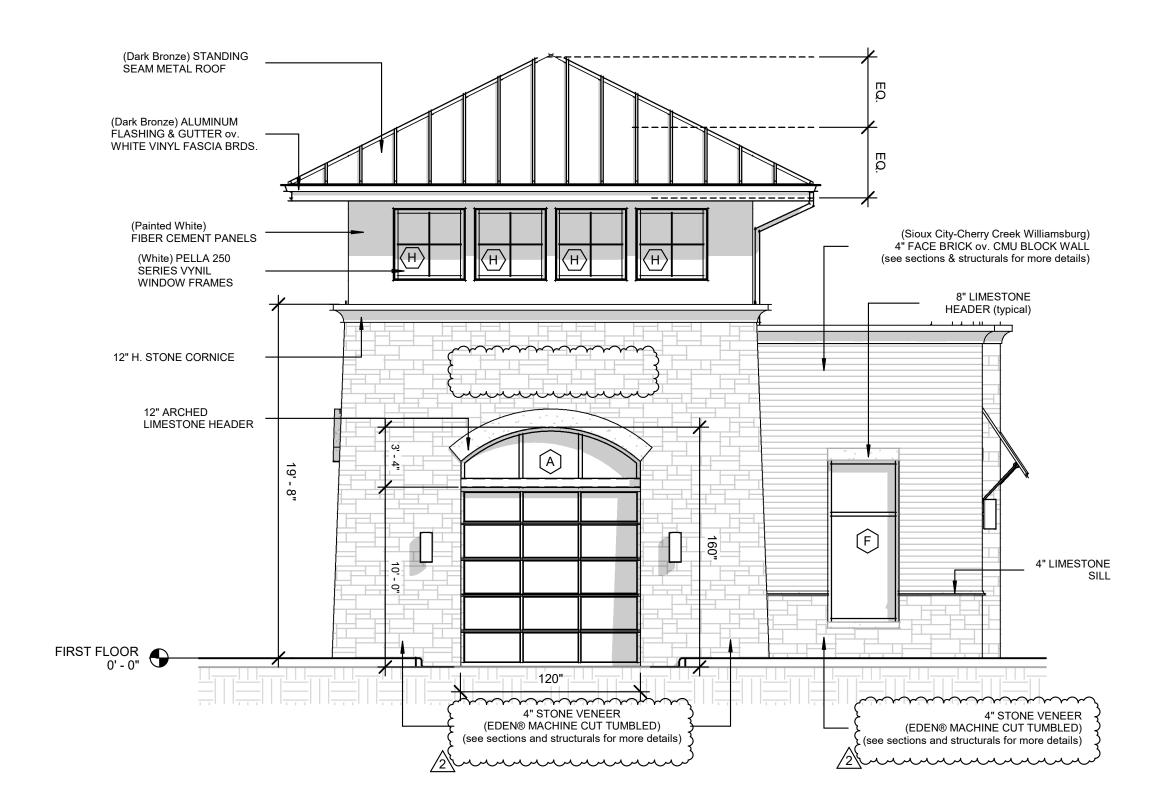

South Elevation. Car Wash

SCALE: 3/16" = 1'-0"



MASONRY	Stone -	721.67 SF	31.7%	85.2%
	Brick -	1,218.60 SF	53.5%	
MASONRY	Stone Cornice	204.36 SF	9.0%	14.8%
LIKE	Fiber Cement -	131.35 SF	5.8%	
TOTAL	TOTAL FACADE -	2,275.98 SF	100.0%	100.0%
	Window -	815.22 SF		·

ARCHITECTURAL ELEMENT(S) - [A.E. #]

- Awnings Peaked Roof Form Arches
- Articulated Cornice Line Offests, projection Expressing Structural Bay

Car Wash South Elevation - material exhibit

C.4 SCALE: 1/8" = 1'-0"

MASONRY	Stone -	979.29 SF	47.4%	85.6%
	Brick -	787.99 SF	38.2%	
MASONRY	Stone Cornice	165.02 SF	8.0%	14.4%
LIKE	Fiber Cement -	131.40 SF	6.4%	
TOTAL	TOTAL FACADE -	2,063.70 SF	100.0%	100.0%
	Window -	1,030.80 SF		

1'-0"

ARCHITECTURAL ELEMENT(S) - [A.E. #]

Awnings Peaked Roof Form

C.4 SCALE: 1/8" = 1'-0"

(Dark Bronze) STANDING

SEAM METAL ROOF [A.E. 2]

(Dark Bronze) ALUMINUM

(Sioux City-Cherry Creek

4" FACE BRICK ov. CMU BLOCK WALL

FLASHING & GUTTER ov. WHITE VINYL FASCIA BRDS.

Williamsburg)

12" H. STONE

CANVAS CANOPY [A.E. 1

CORNICE [A.E. 4]

4" LIMESTONE

4" STONE VENEER

(EDEN® MACHINE CUT TUMBLED)

details)

 $ar{}$ (see sections and structurals for more ${}_{arsigma}$

Articulated Cornice Line Offests, projection Expressing Structural Bay

² Car Wash North Elevation - material exhibit

(Painted White)

FIBER CEMENT PANELS

(White) PELLA 250

WINDOW FRAMES

12" H. STONE

CORNICE [A.E. 4]

SÉRIES VINYL

12" ARCHED LIMESTONE HEADER

[A.E. 3]


(see sections and structurals for more details)

(EDEN® MACHINE CUT TUMBLED)


4" STONE VENEER

Articulated Cornice Line Offests, projection Expressing Structural Bay

MASONRY	Stone -	367.82 SF	59.9%	83.2%
	Brick -	143.19 SF	23.3%	
MASONRY LIKE	Stone Cornice	37.45 SF	6.1%	16.8%
LIKE	Fiber Cement -	65.48 SF	10.7%	
TOTAL	TOTAL FACADE -	613.94 SF	100.0%	100.0%
	Window -	229.98 SF		

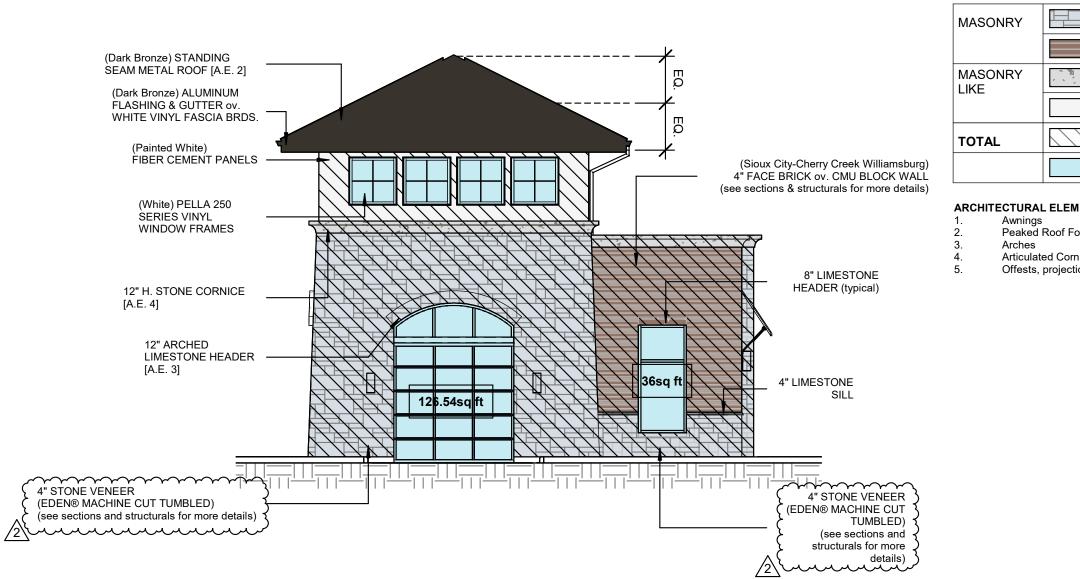



,	4	Car Wash West Elevation - material exhibit
,	C.4	SCALE: 1/8" = 1'-0"

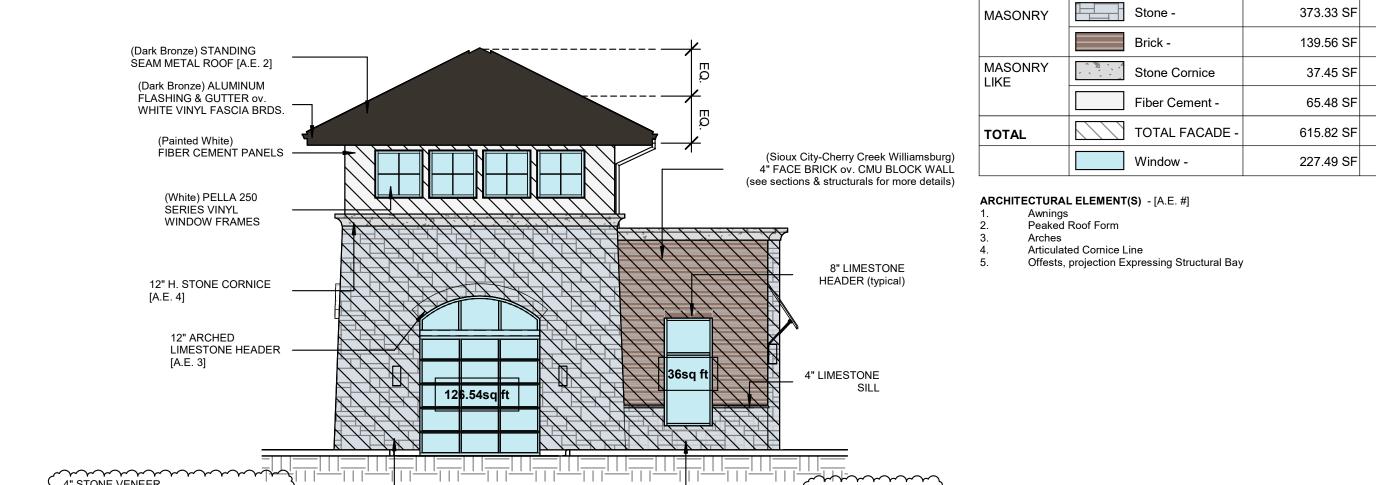

Car Wash East Elevation - material exhibit C.4 SCALE: 1/8" = 1'-0"

PROJECT # 2334 DATE: 12/06/23 CILIT C **AUTOMATED** E. DEBBIE ISFIELD, T) NEW 585 E 2 01.08.24 ZONING REVISION 12.12.23 ZONING REVISION 10.18.23 ZONING REVIEW **REVISIONS** DRAWN BY: APPROVED BY: GCN / MAM AS NOTED DESCRIPTION: CAR WASH MAIN **ELEVATIONS** naterial exhibits SHEET NO.

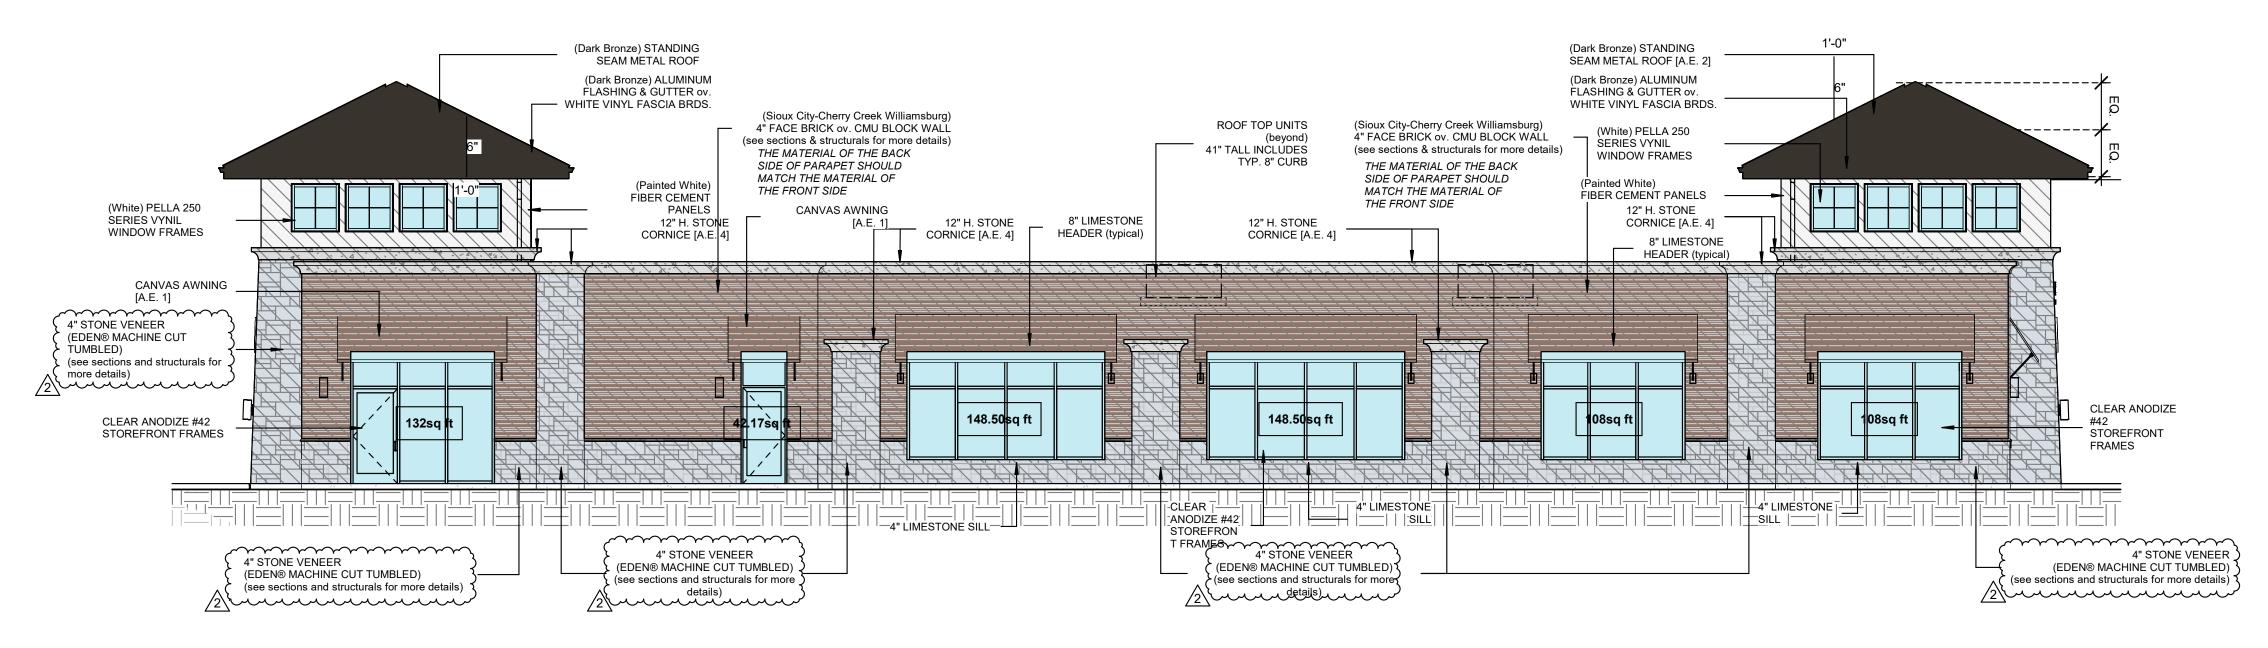

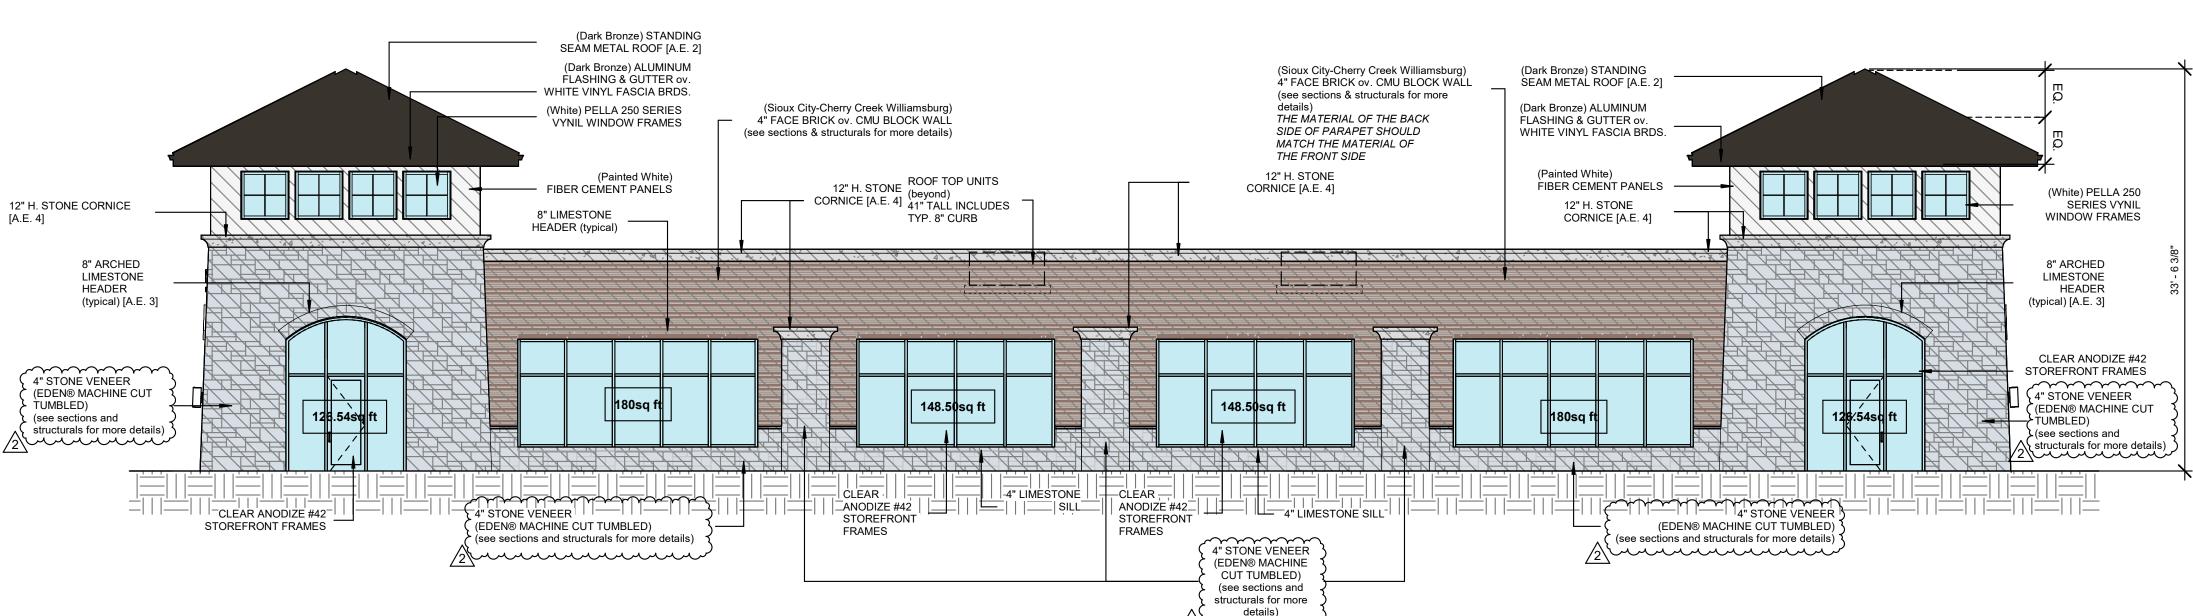

60.6%

6.1%


10.6%


100.0%


83.3%


16.7%

100.0%

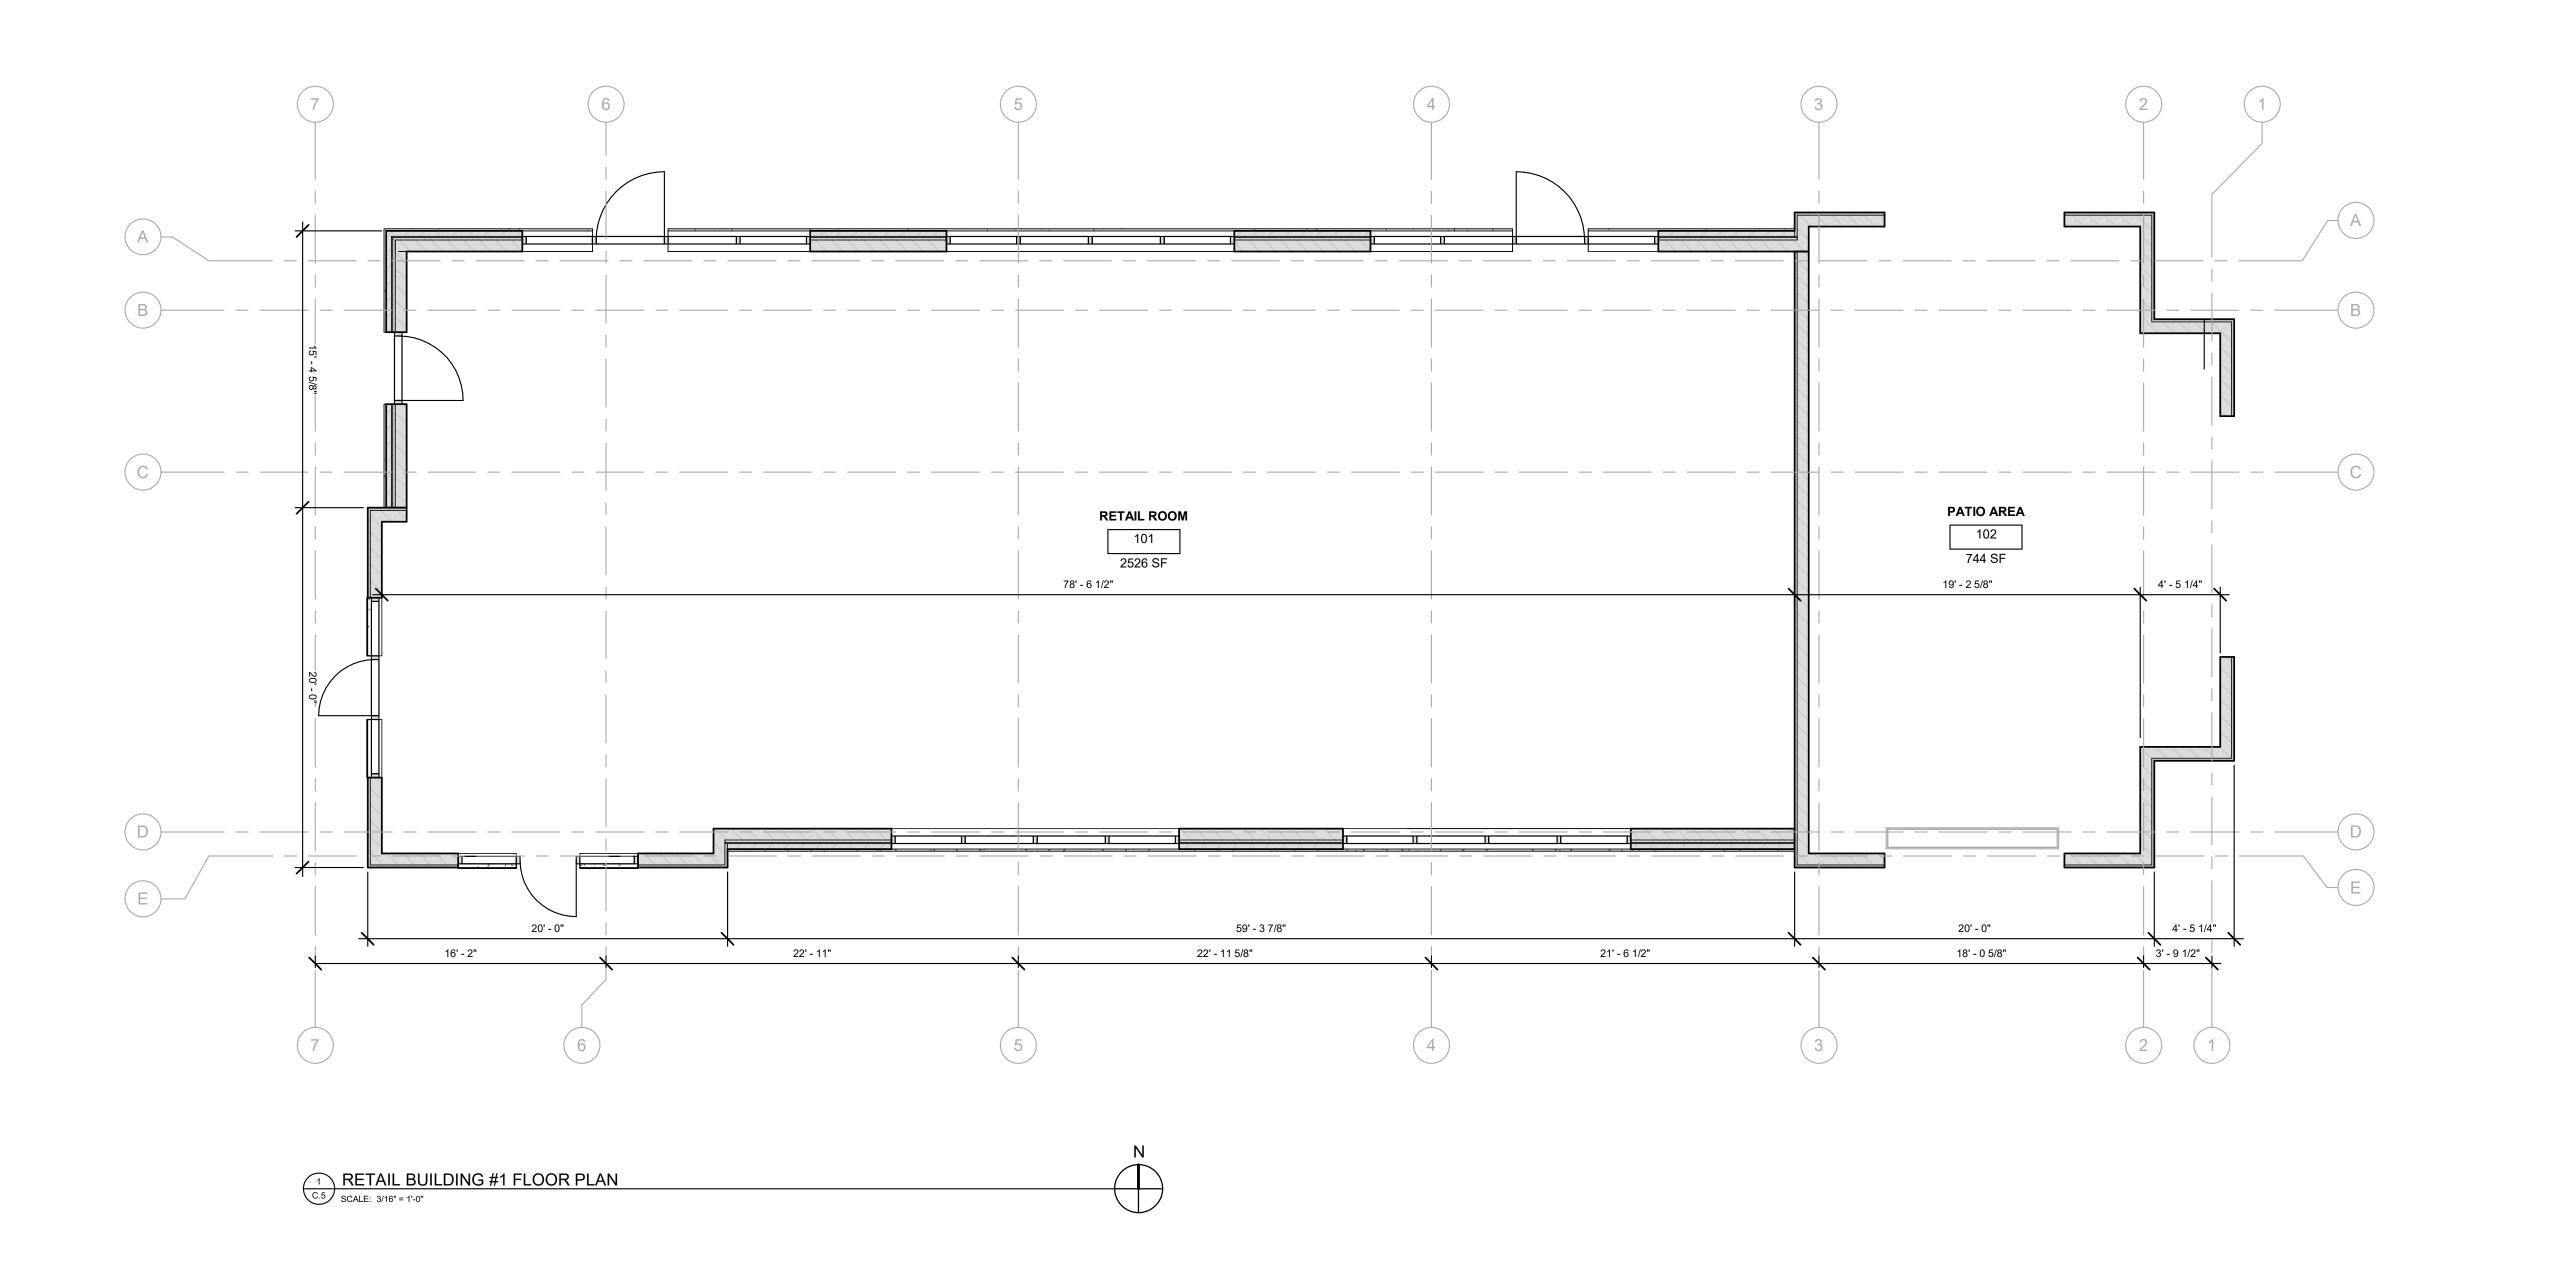

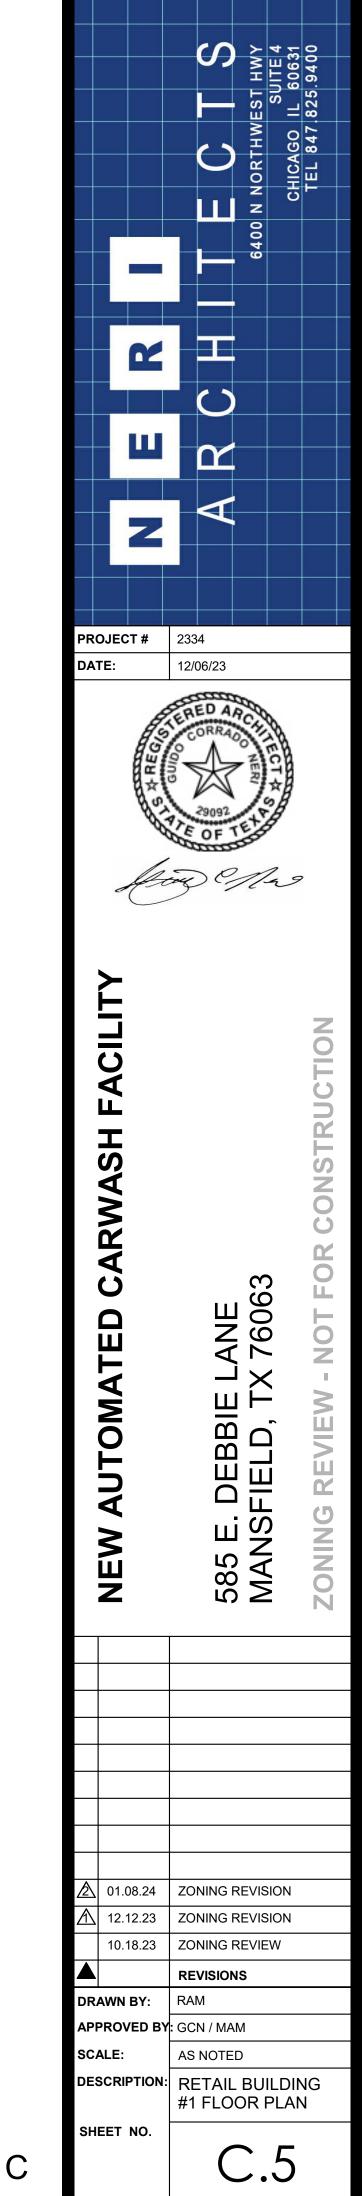

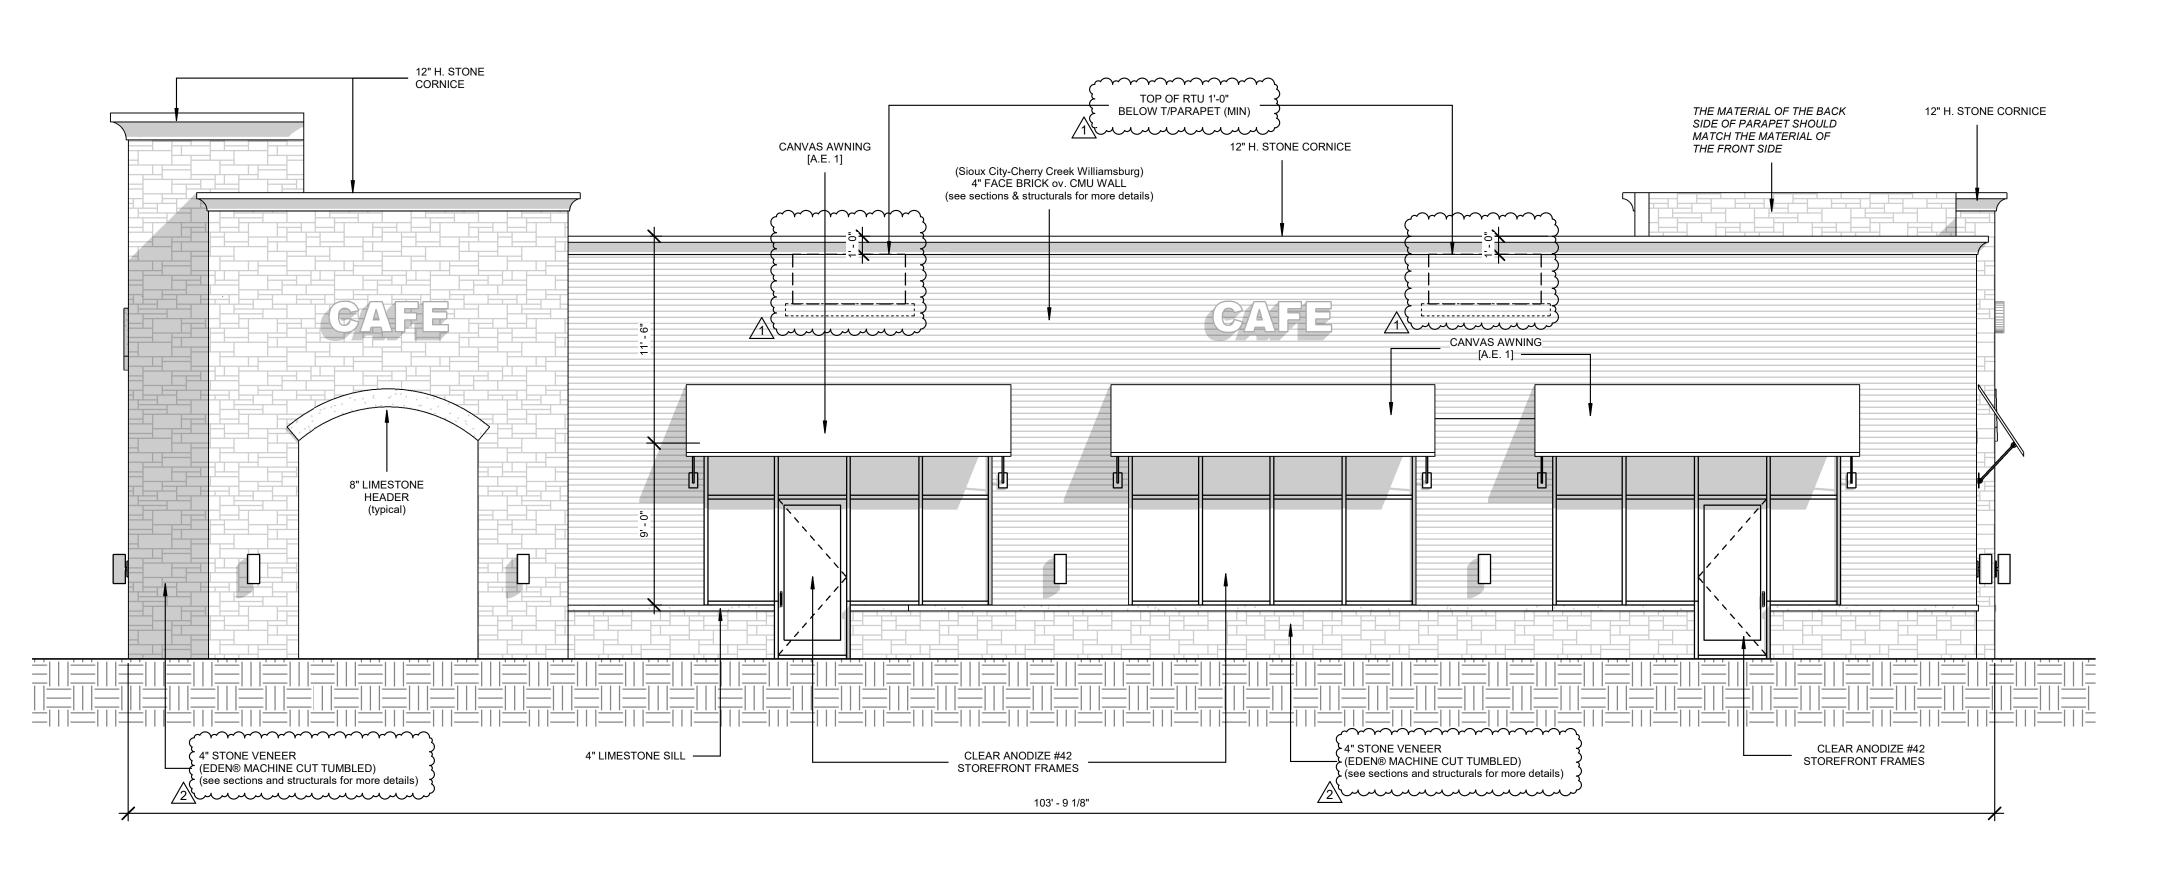

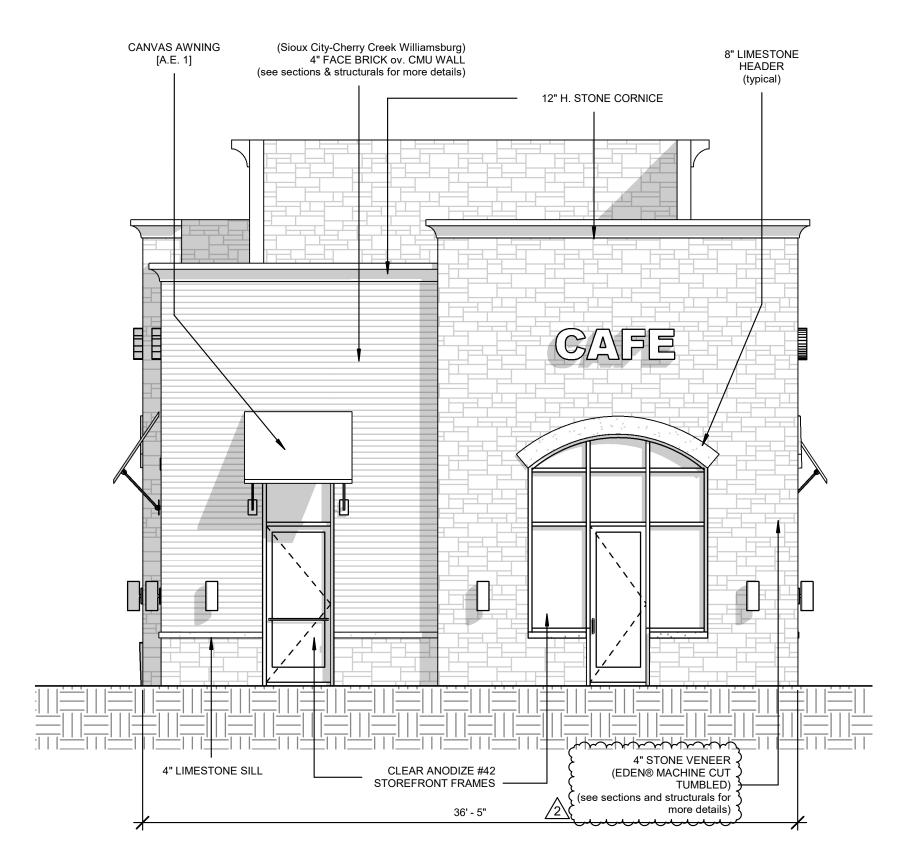


West Elevation. Proposed Retail Building #1.

C.6 SCALE: 3/16" = 1'-0"


North Elevation. Proposed Retail Building #1.

SCALE: 3/16" = 1'-0"

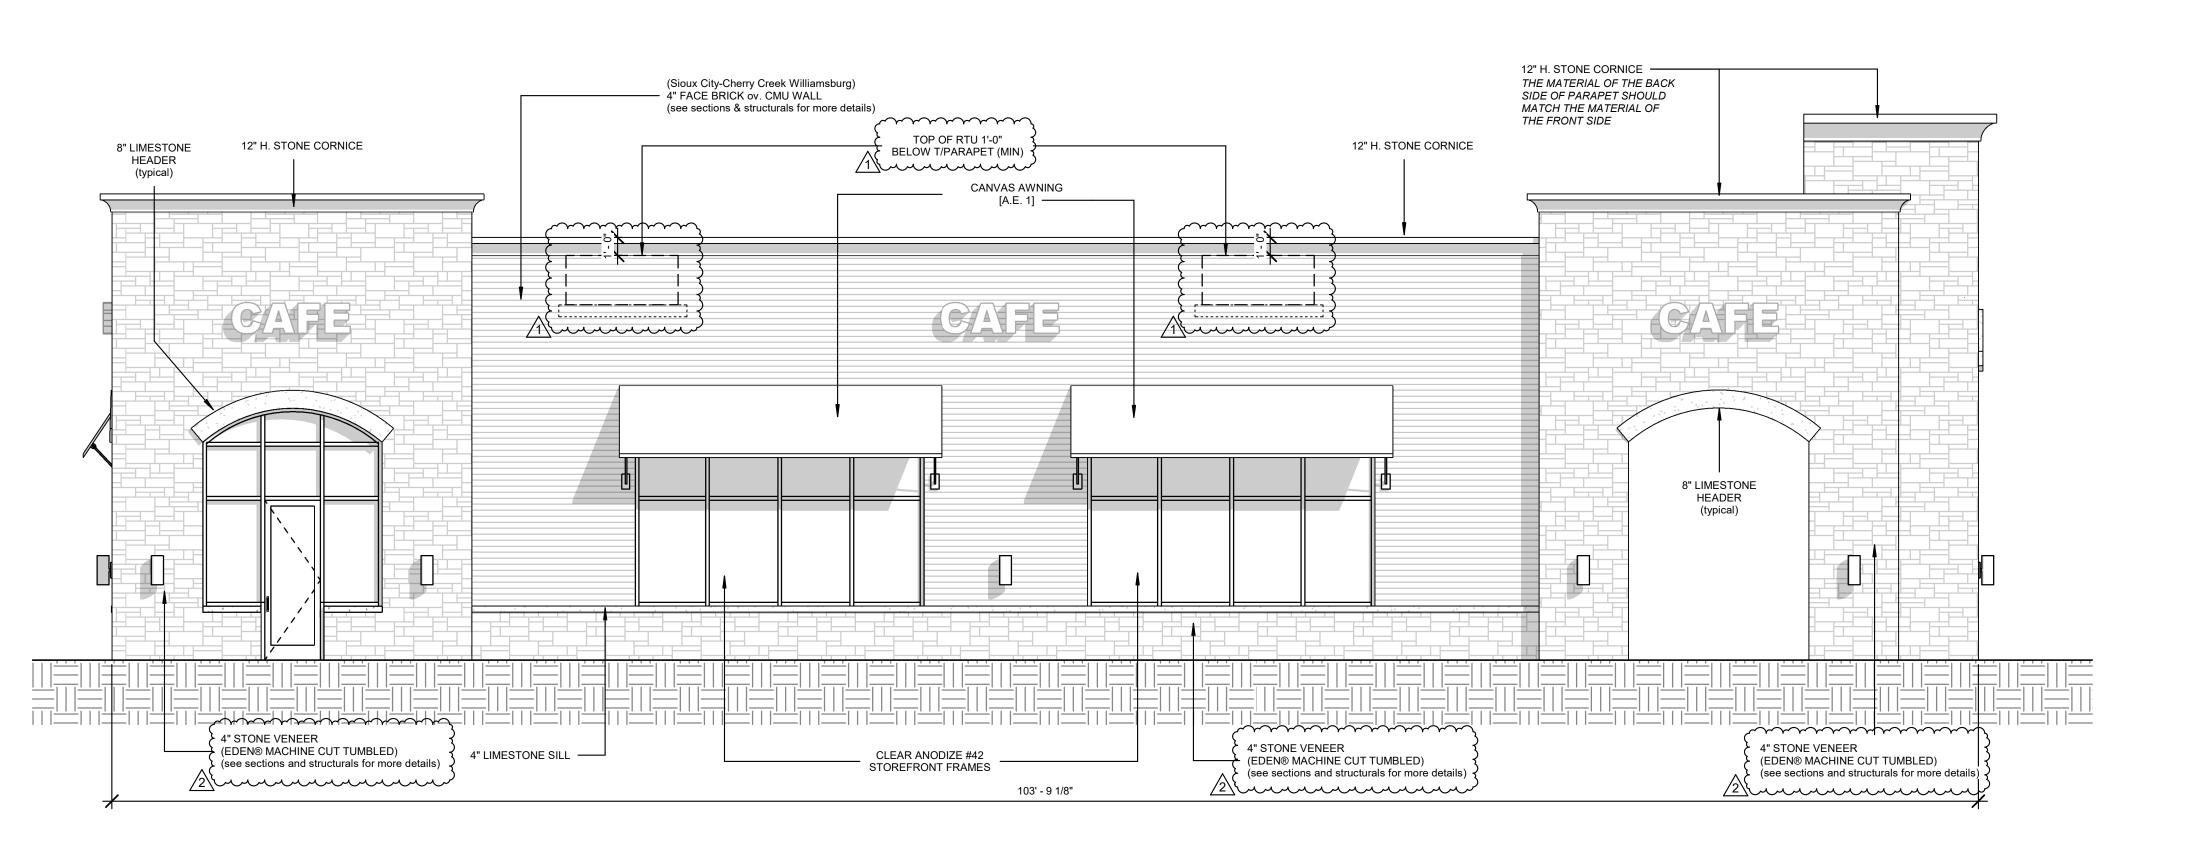

South Elevation. Proposed Retail Building #1.

SCALE: 3/16" = 1'-0"

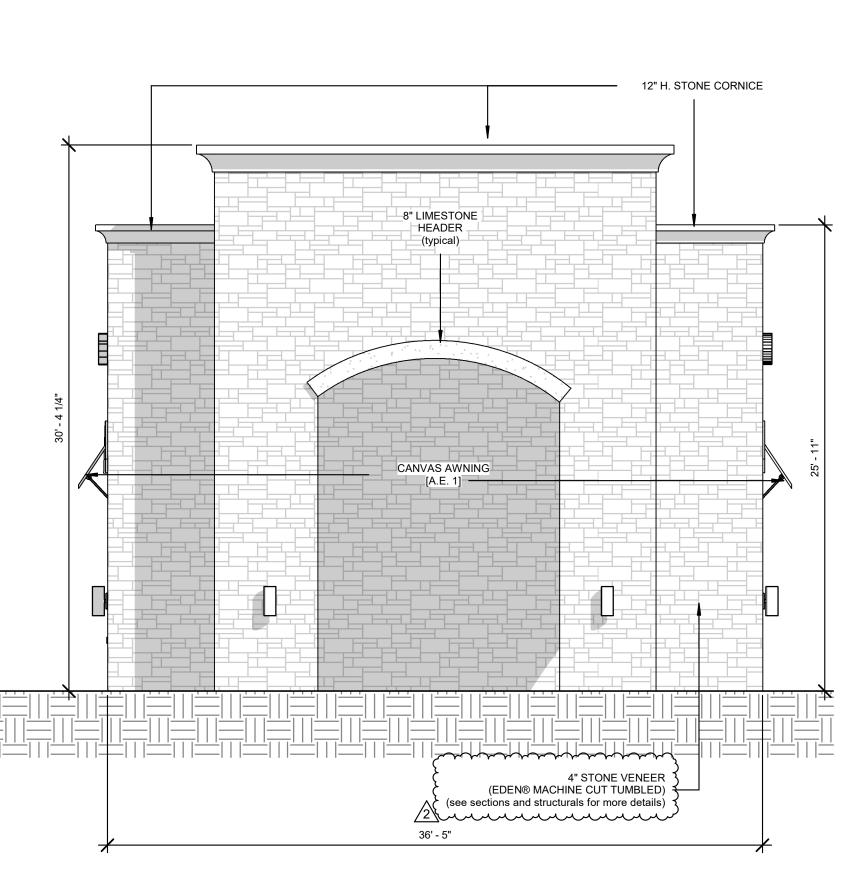

East Elevation. Proposed Retail Building #1.


4 24x36

C.6 SCALE: 3/16" = 1'-0"


SIGNAGE ON COMMERCIAL/RETAIL BUILDINGS IS REPRESENTATIVE ONLY. ACTUAL SIGNAGE WILL BE SUBMITTED FOR REVIEW AND PERMITTED BY INDIVIDUAL END USER

Exhibit C


SHEET NO.

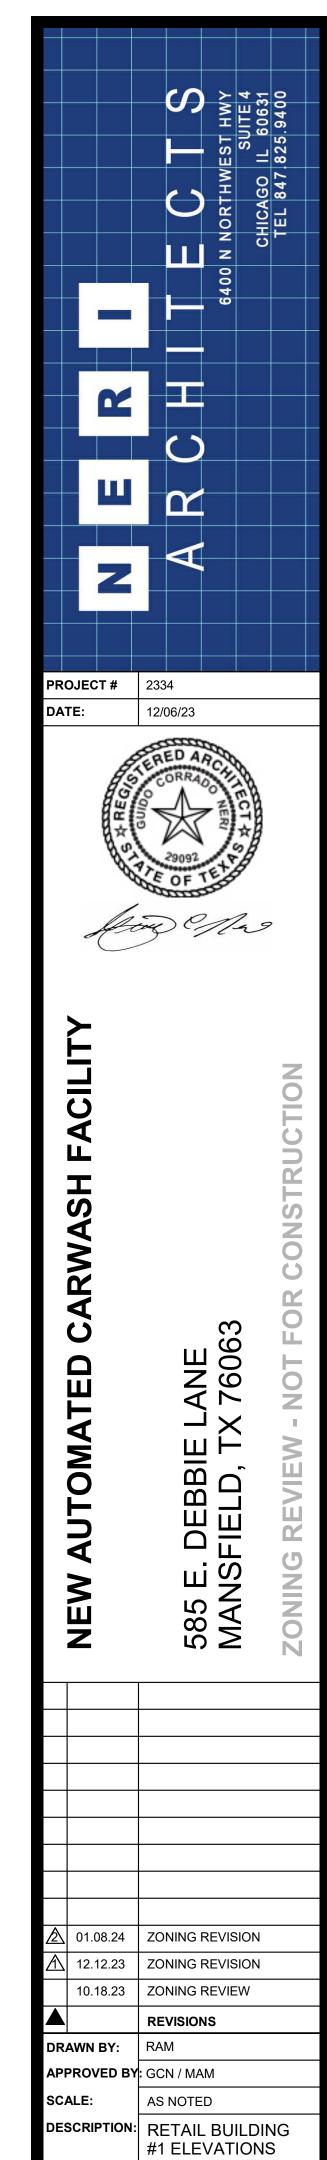

North Elevation. Proposed Retail Building #1 material exhibit C.7 SCALE: 1/8" = 1'-0"

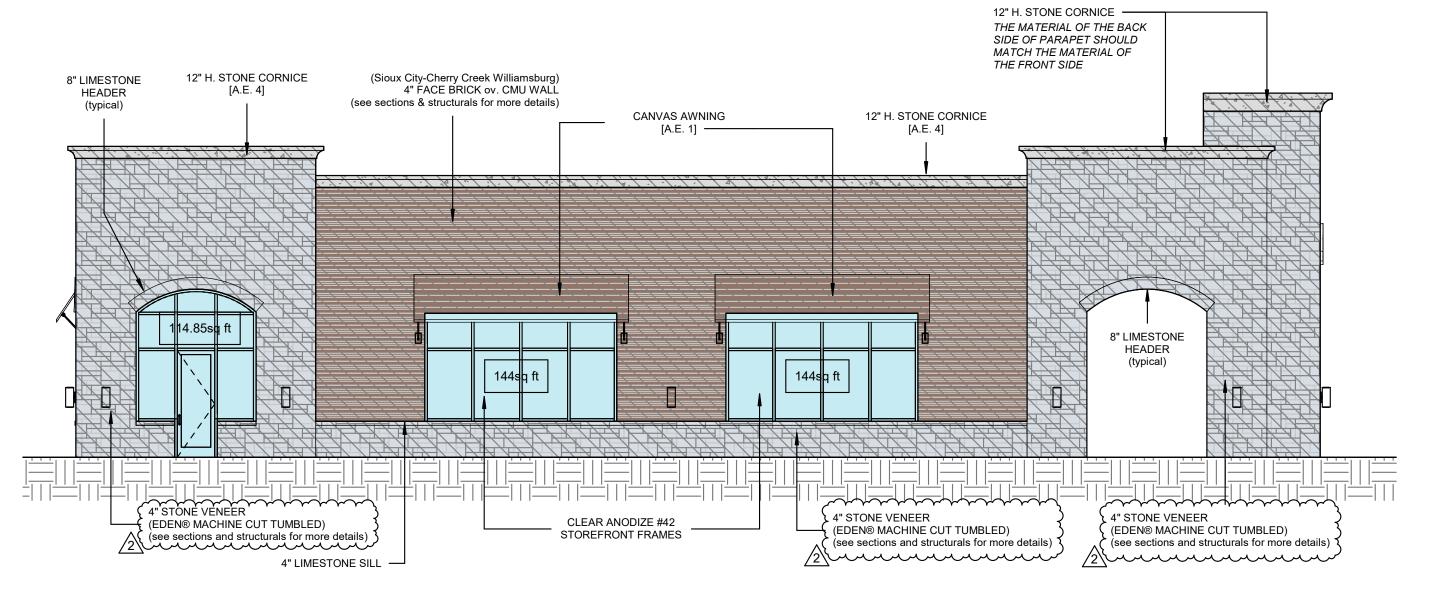

South Elevation. Proposed Retail Building #1 material exhibit C.7 SCALE: 1/8" = 1'-0"

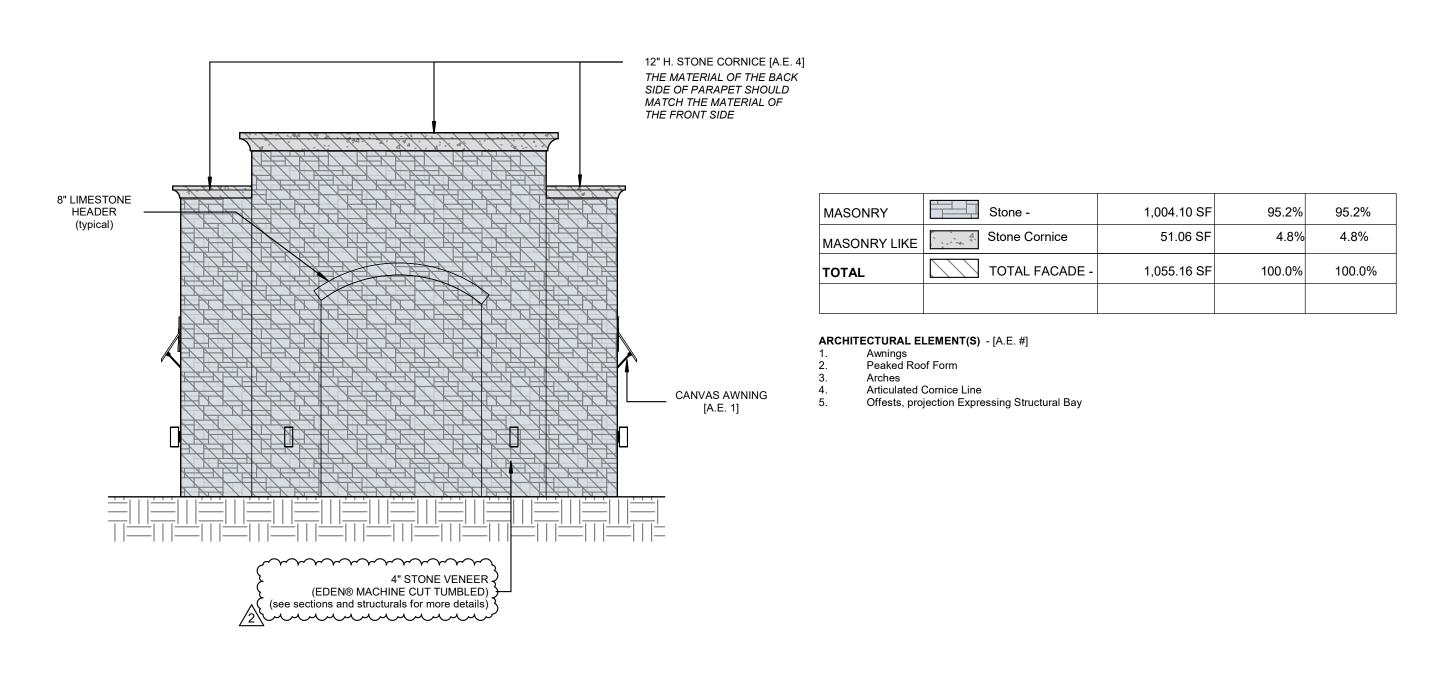

East Elevation. Proposed Retail Building #1 material exhibit C.7 SCALE: 1/8" = 1'-0"

MACONDV	Stone -	743.78 SF	38.0%	94%
MASONRY	Brick -	1,094.93 SF	56.0%	
MASONRY LIKE	Stone Cornice	117.35 SF	6.0%	6%
TOTAL	TOTAL FACADE -	1,956.06 SF	100.0%	100.0%
	Window -	457.25 SF		


ARCHITECTURAL ELEMENT(S) - [A.E. #]

- Awnings Peaked Roof Form
- Articulated Cornice Line
- Offests, projection Expressing Structural Bay

MASONRY	Stone -	1,068.93 SF	52.0%	94.3%
WASONKT	Brick -	868.78 SF	42.3%	
MASONRY LIKE	Stone Cornice	116.20 SF	5.7%	5.7%
TOTAL	TOTAL FACADE -	2053.91 SF	100.0%	100.0%
	Window -	402.85 SF		

ARCHITECTURAL ELEMENT(S) - [A.E. #]

- Awnings Peaked Roof Form
- Articulated Cornice Line Offests, projection Expressing Structural Bay

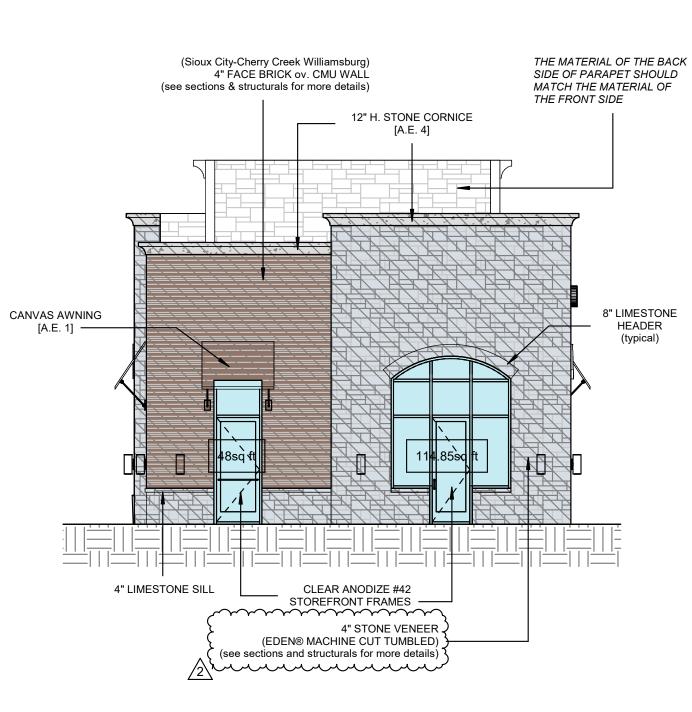



MACONDY	Stone -	444.43 SF	59.5%	94.8%
MASONRY	Brick -	264.11 SF	35.3%	
MASONRY LIKE	Stone Cornice	39.02 SF	5.2%	5.2%
TOTAL	TOTAL FACADE -	747.56 SF	100.0%	100.0%
	Window -	162.85 SF		

- ARCHITECTURAL ELEMENT(S) [A.E. #]
- Awnings Peaked Roof Form
- Articulated Cornice Line Offests, projection Expressing Structural Bay


	West Elevation. Proposed Retail Building #1 -
$\sqrt{3}$	material exhibit


3 material exhibit
C.7 SCALE: 1/8" = 1'-0"

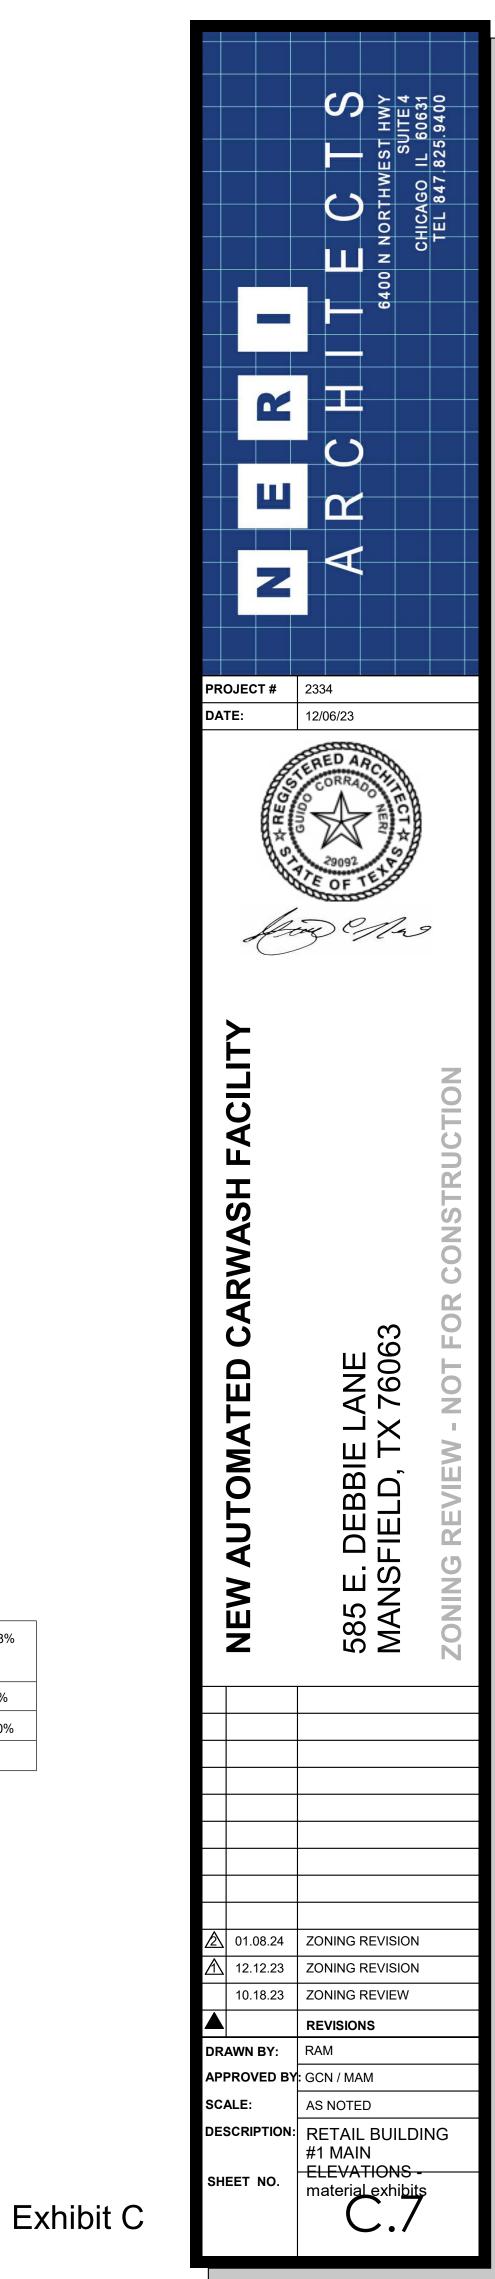

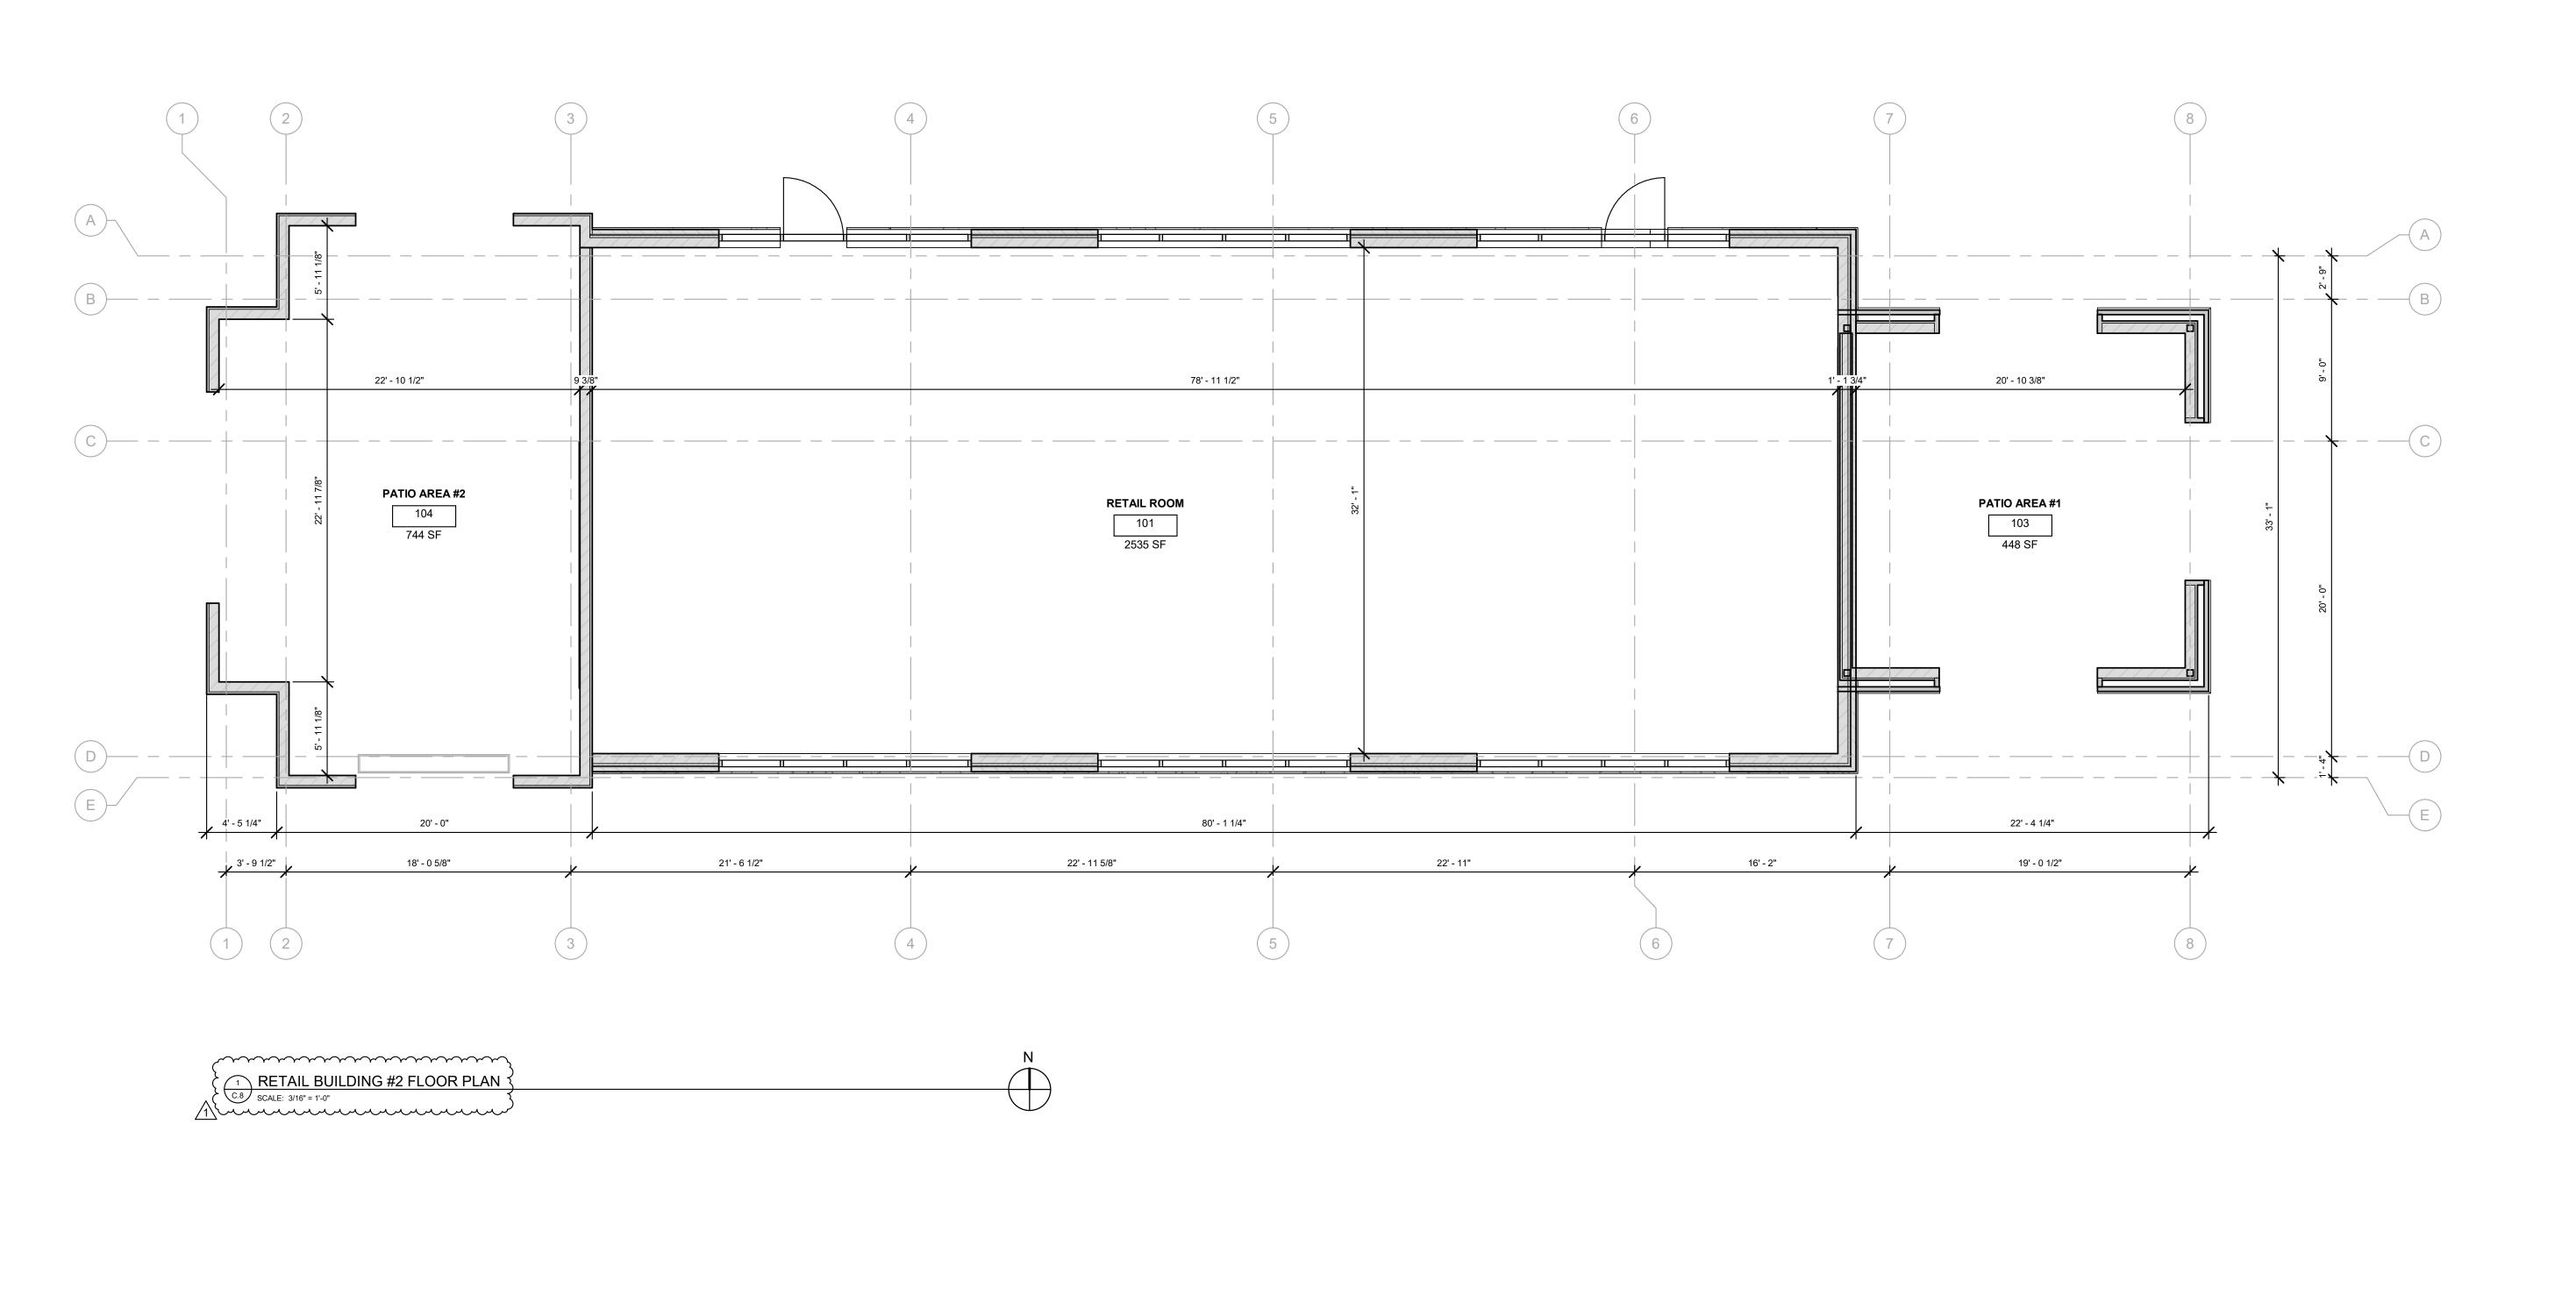



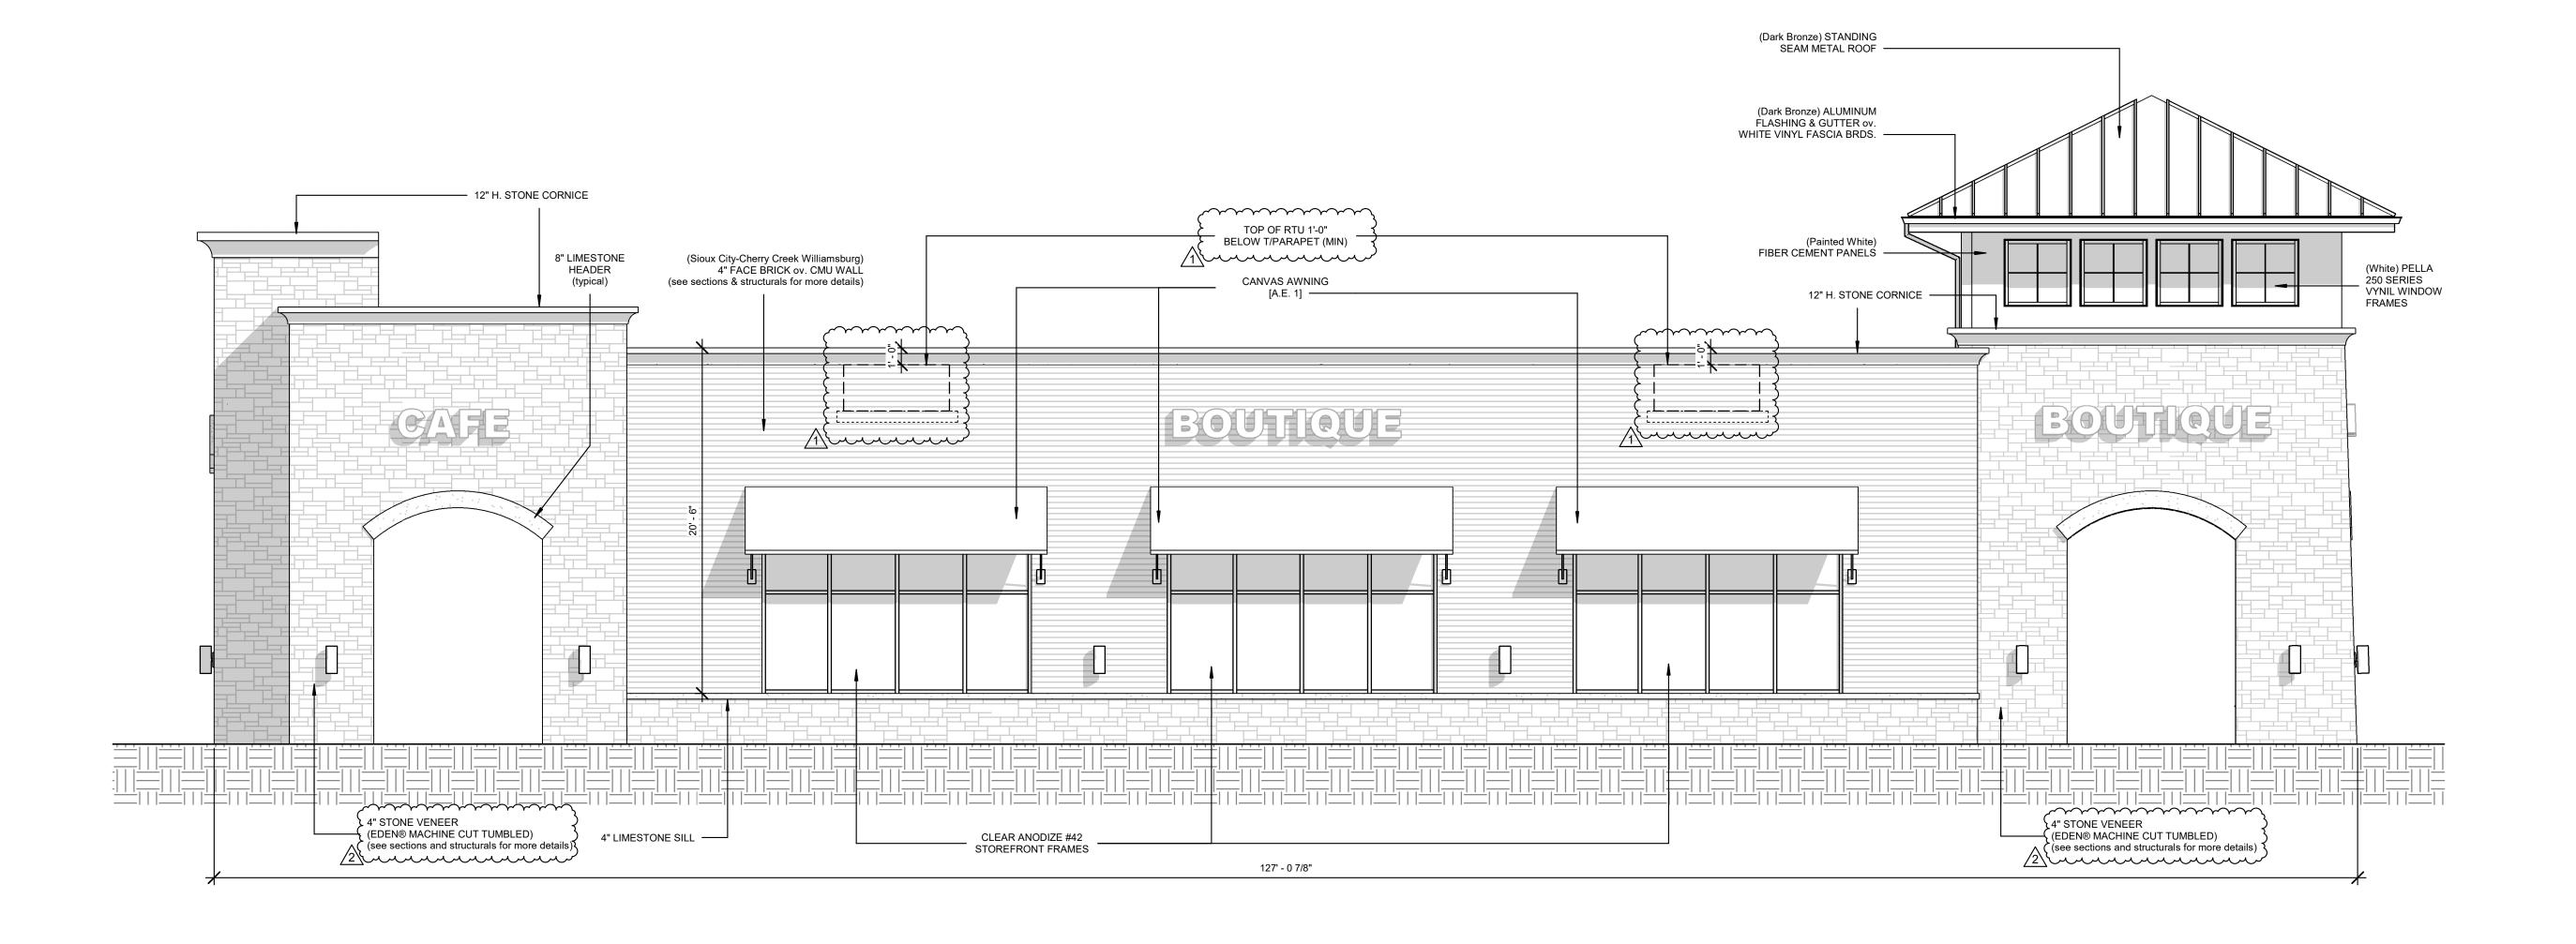

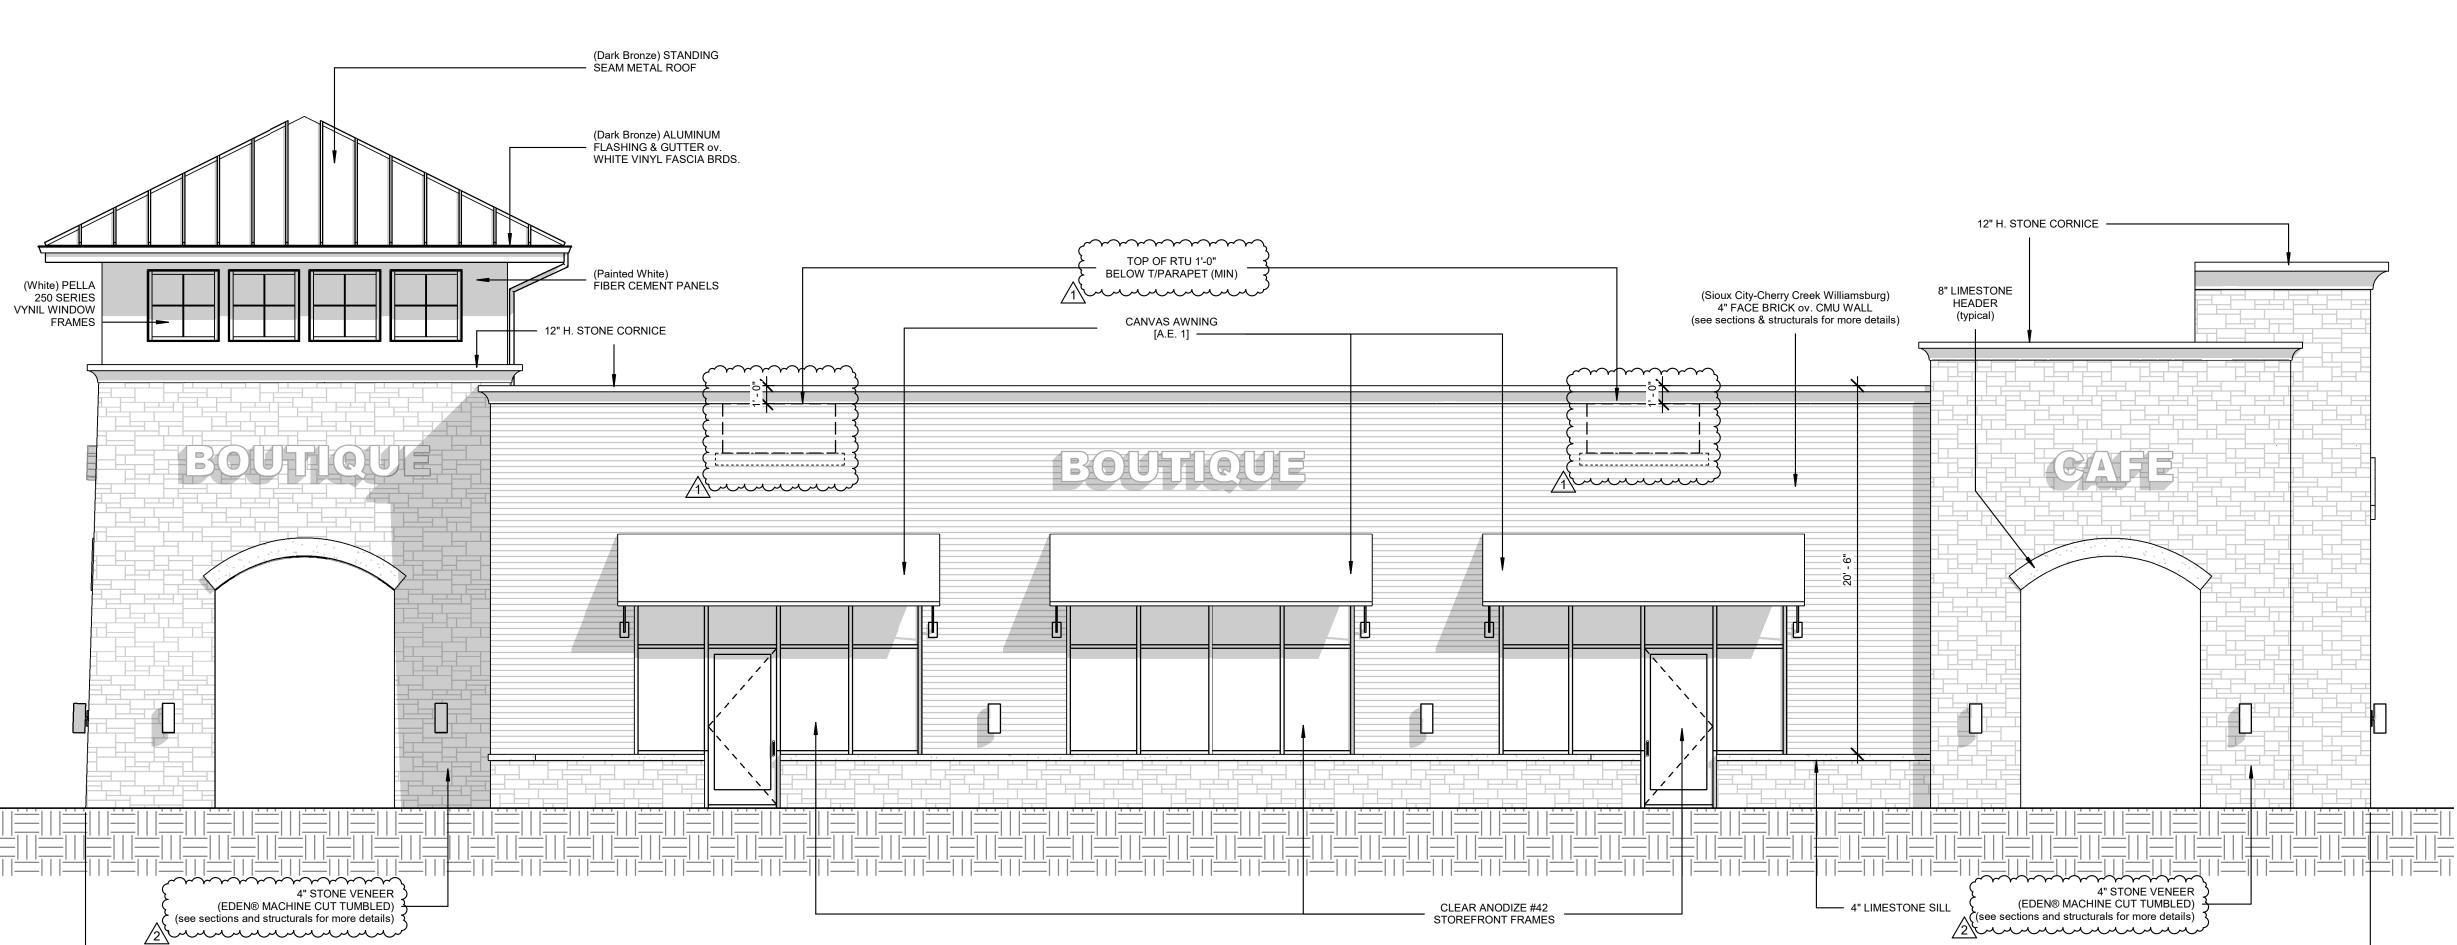

127' - 0 1/8"

AUTOMATED NEW 2 01.08.24 ZONING REVISION 12.12.23 | ZONING REVISION 10.18.23 ZONING REVIEW <u>/2</u> DRAWN BY: RAM APPROVED BY: GCN / MAM DESCRIPTION: RETAIL BUILDING SHEET NO. SIGNAGE ON COMMERCIAL/RETAIL BUILDINGS IS REPRESENTATIVE ONLY. ACTUAL SIGNAGE WILL BE SUBMITTED FOR REVIEW AND PERMITTED BY INDIVIDUAL END USER Exhibit C

PROJECT # 2334

12/06/23

DATE:

CILIT

ARW,

S

: LANE -X 76063

585 E. DEBBIE I MANSFIELD, TX

REVISIONS


AS NOTED


#2 ELEVATIONS

REVIE

South Elevation. Proposed Retail Building #2.

SCALE: 3/16" = 1'-0"

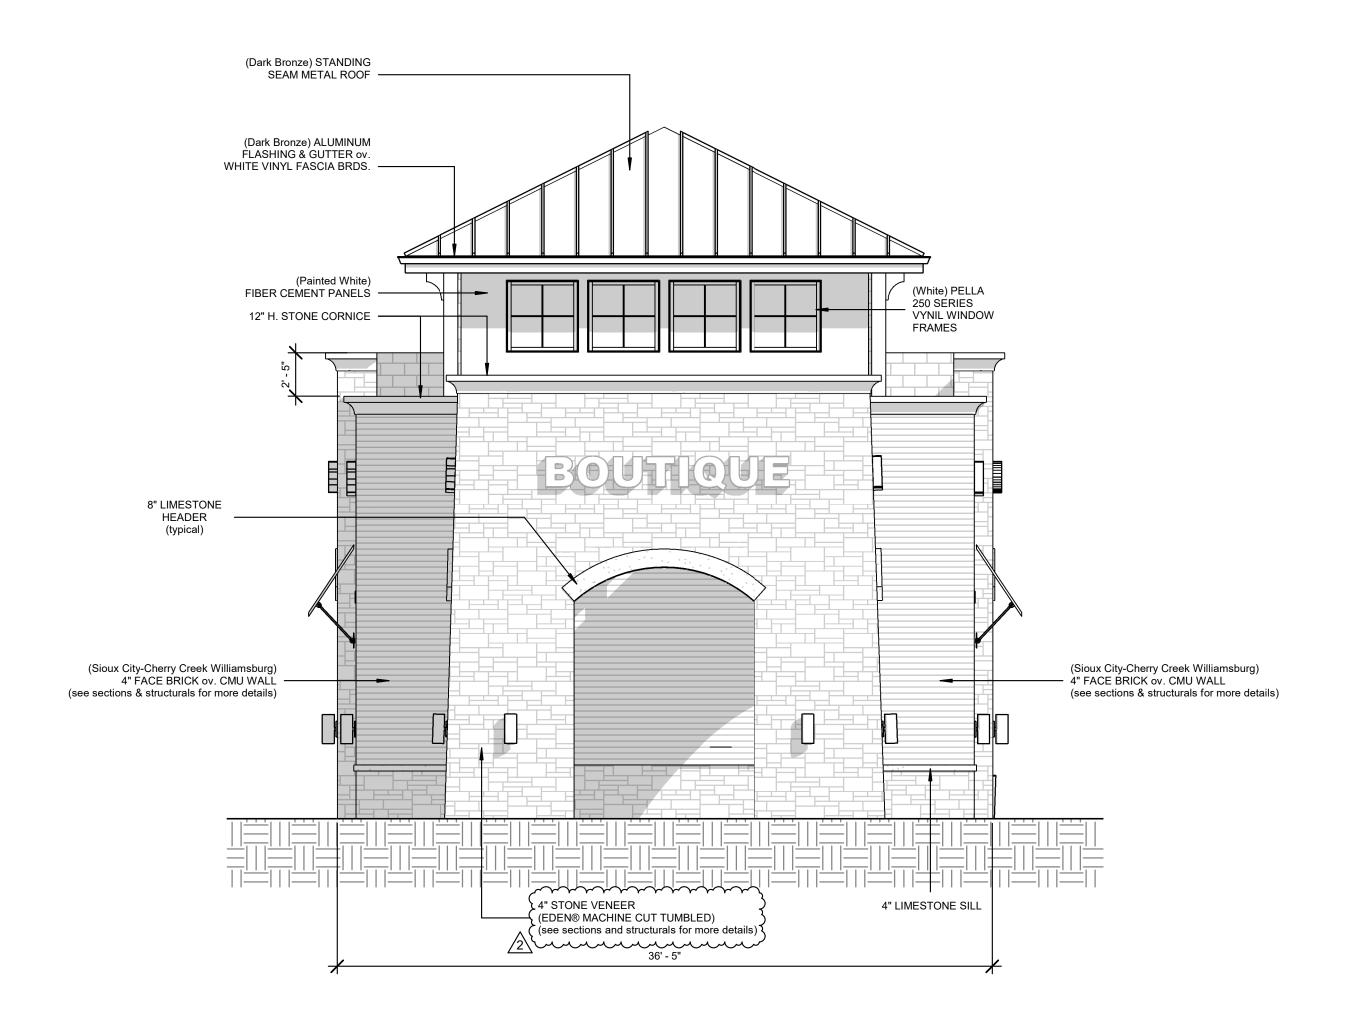

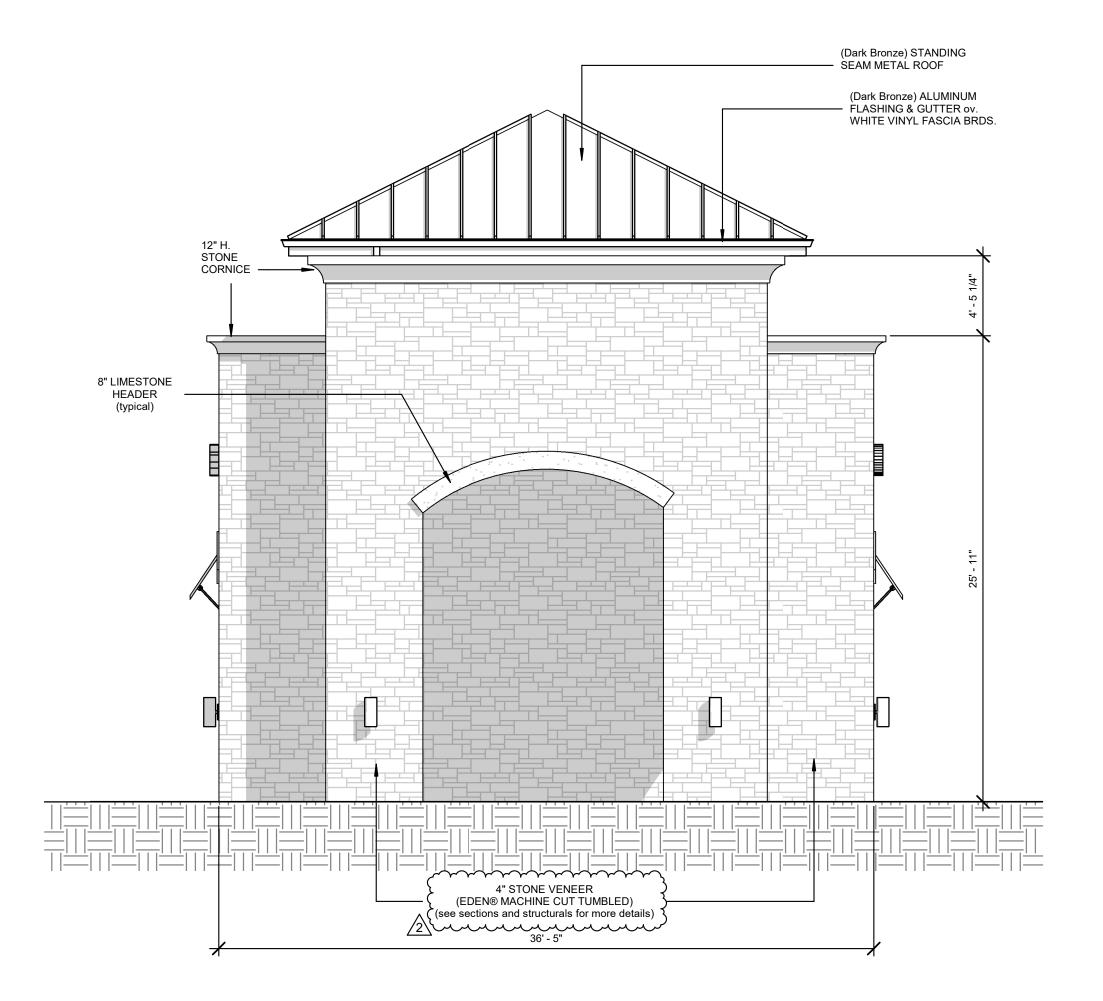


East Elevation. Proposed Retail Building #2.

24x36

C.10 SCALE: 3/16" = 1'-0"

SIGNAGE ON COMMERCIAL/RETAIL BUILDINGS IS REPRESENTATIVE ONLY. ACTUAL SIGNAGE WILL BE SUBMITTED FOR REVIEW AND PERMITTED BY INDIVIDUAL END USER

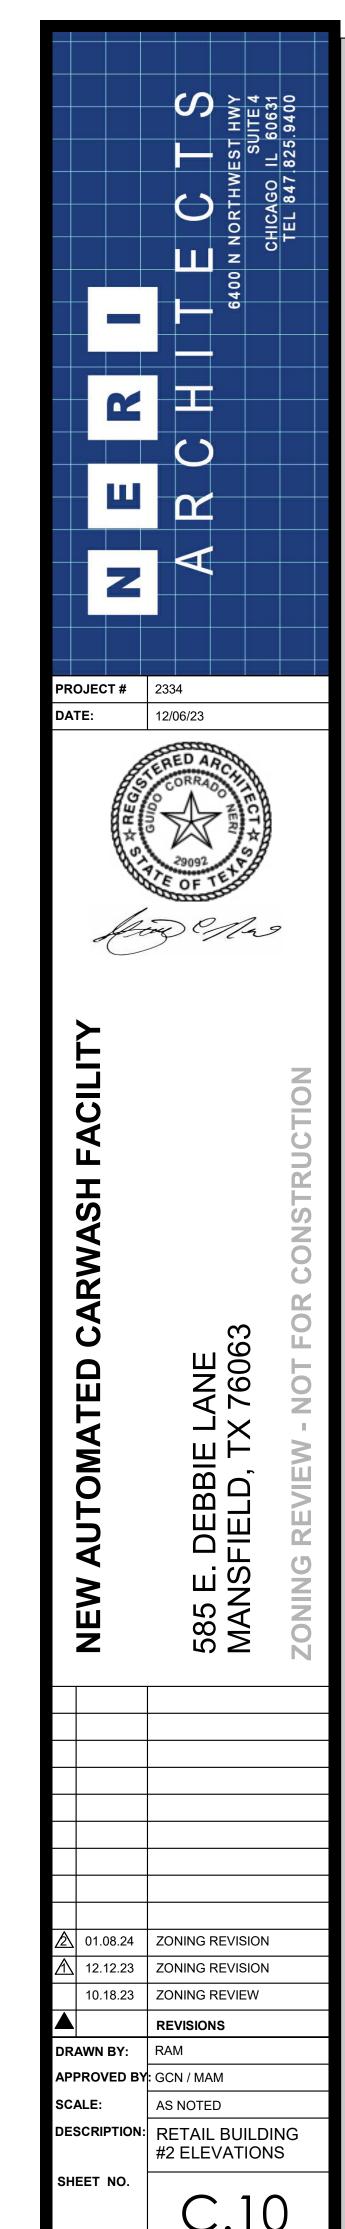




C.11 SCALE: 1/8" = 1'-0"

C.11 SCALE: 1/8" = 1'-0"


PROJECT # 2334 DATE: 12/06/23 CILIT C **AUTOMATED** E. DEBBIE NSFIELD, T) NEW 585 E 2 01.08.24 ZONING REVISION 12.12.23 ZONING REVISION 10.18.23 ZONING REVIEW **REVISIONS** DRAWN BY: APPROVED BY: GCN / MAM AS NOTED DESCRIPTION: RETAIL BUILDING #2 MAIN ELEVATIONS -SHEET NO.


Exhibit C

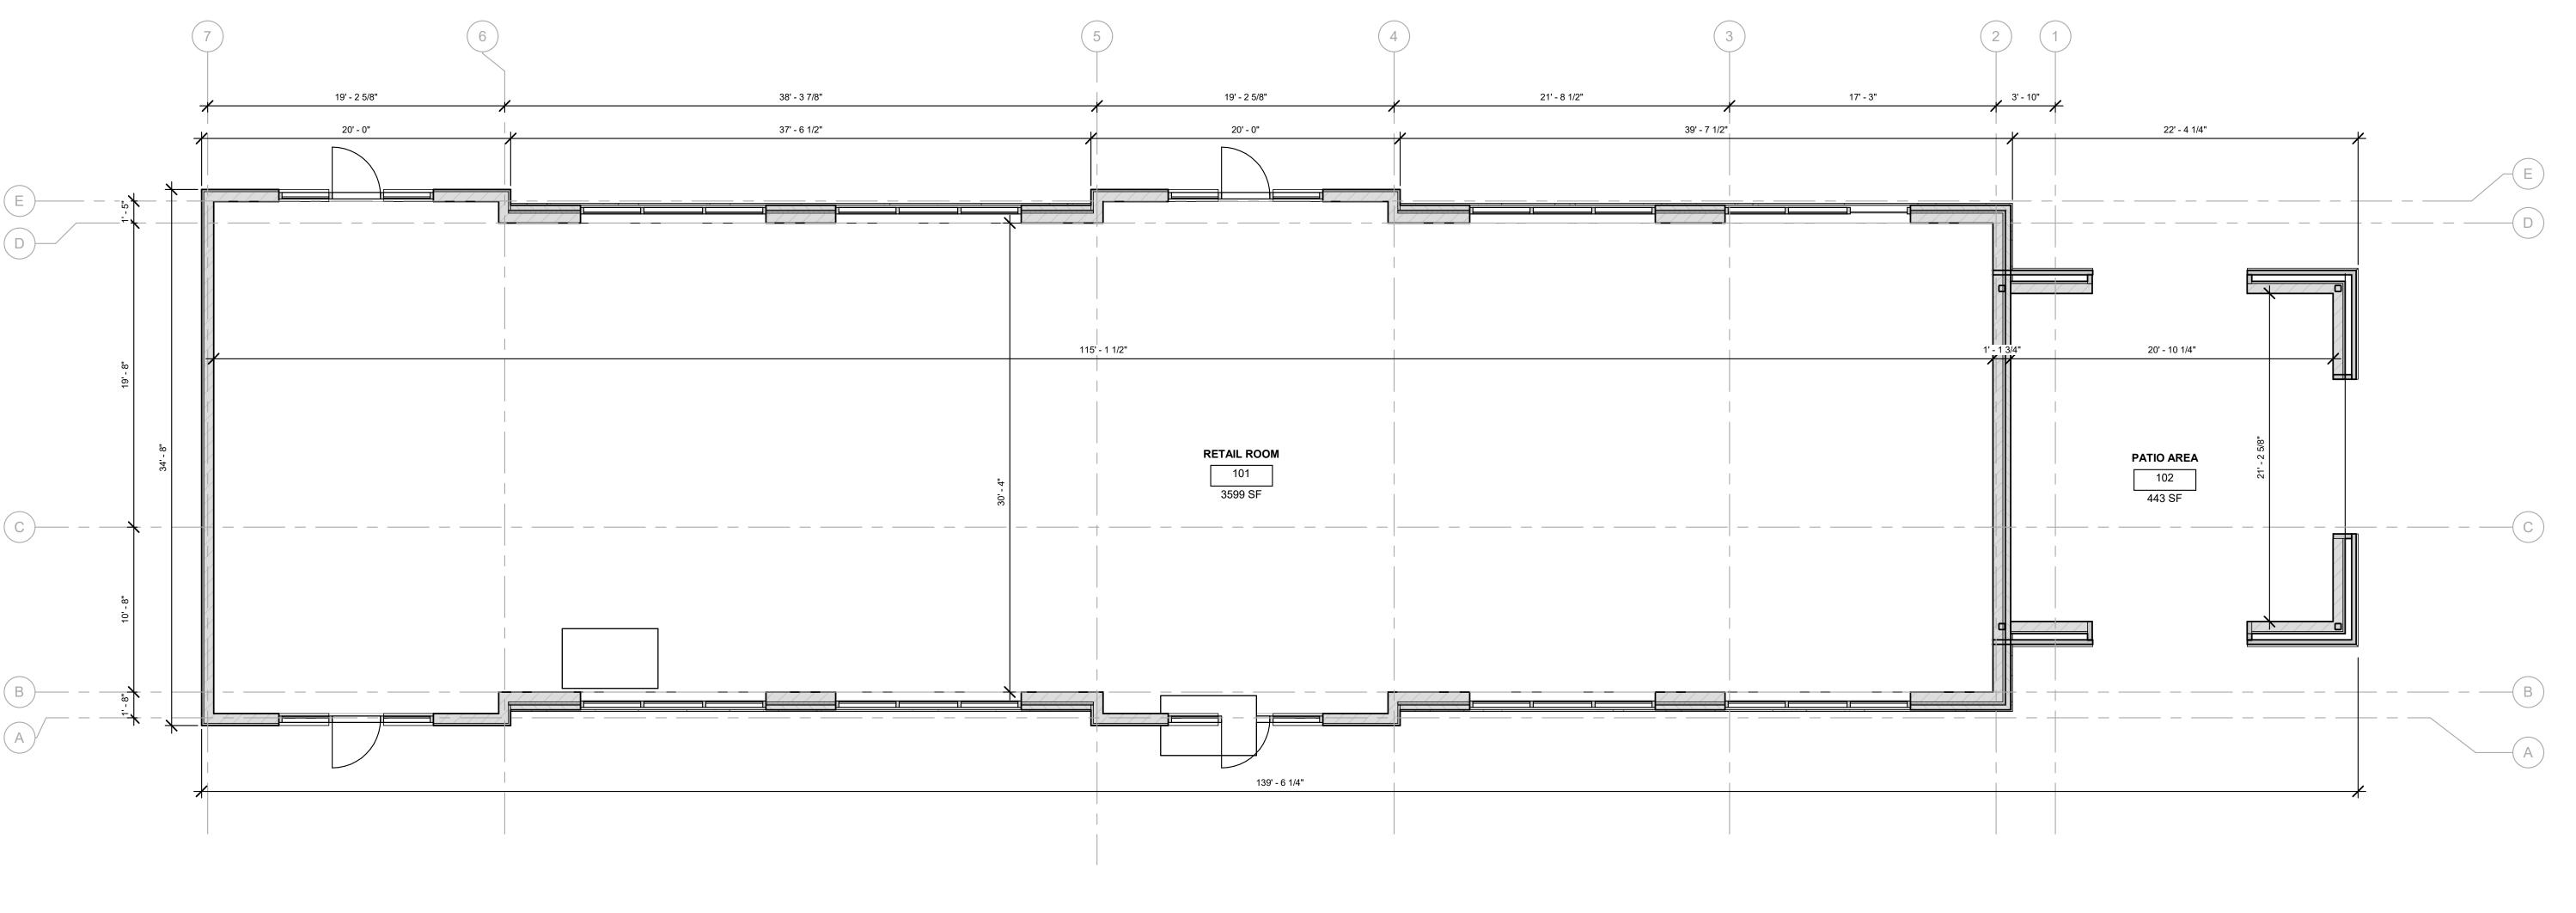

RETAIL BUILDING #3 FLOOR PLAN

SCALE: 3/16" = 1'-0"

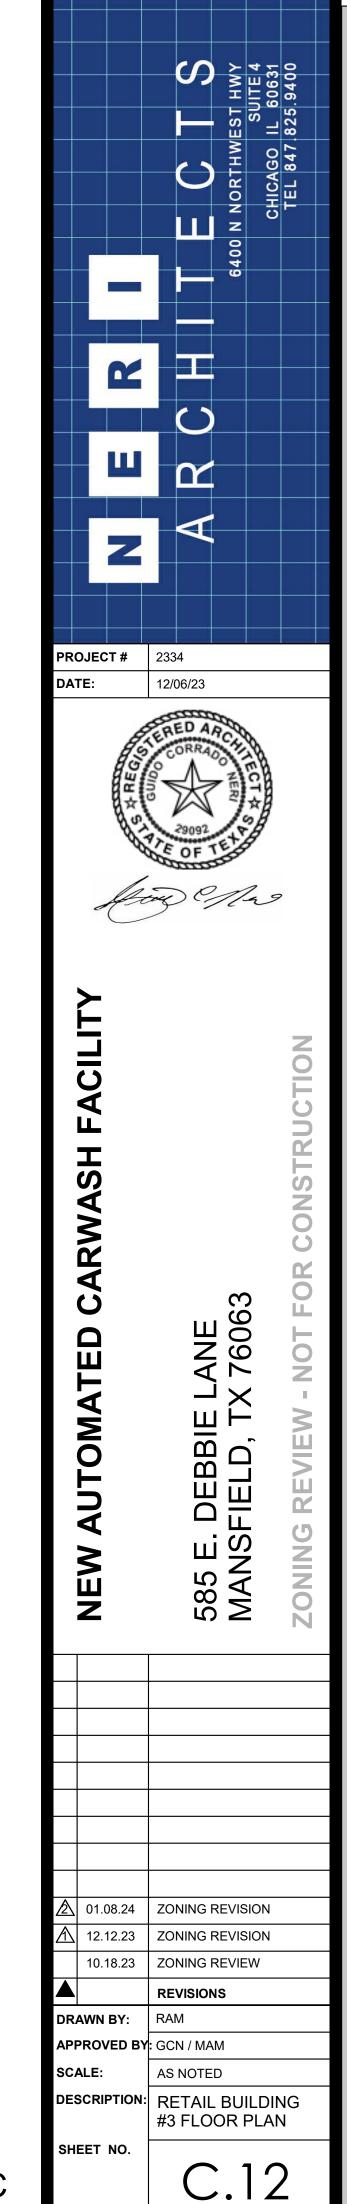

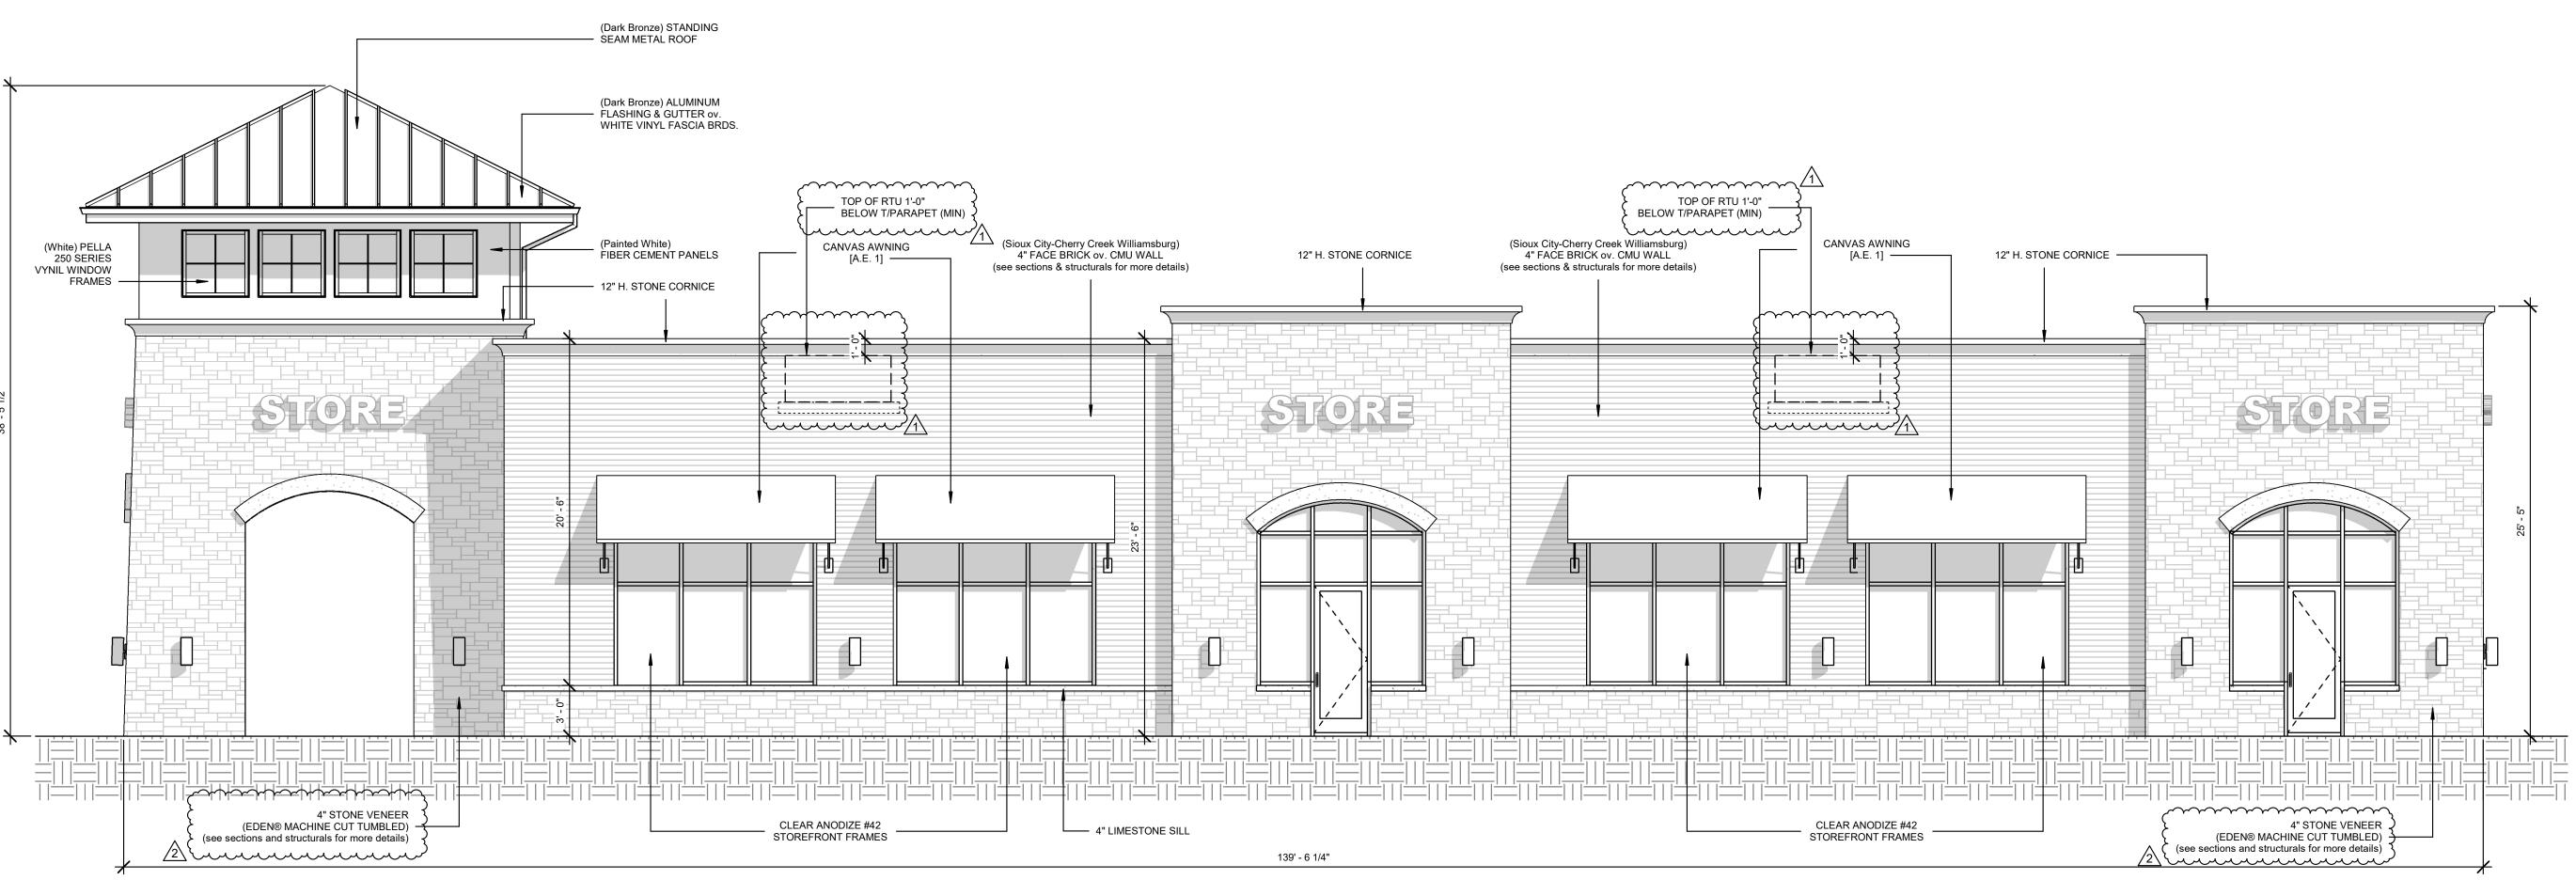


East Elevation. Proposed Retail Building #3.

SCALE: 3/16" = 1'-0"



West Elevation. Proposed Retail Building #3.


SCALE: 3/16" = 1'-0"

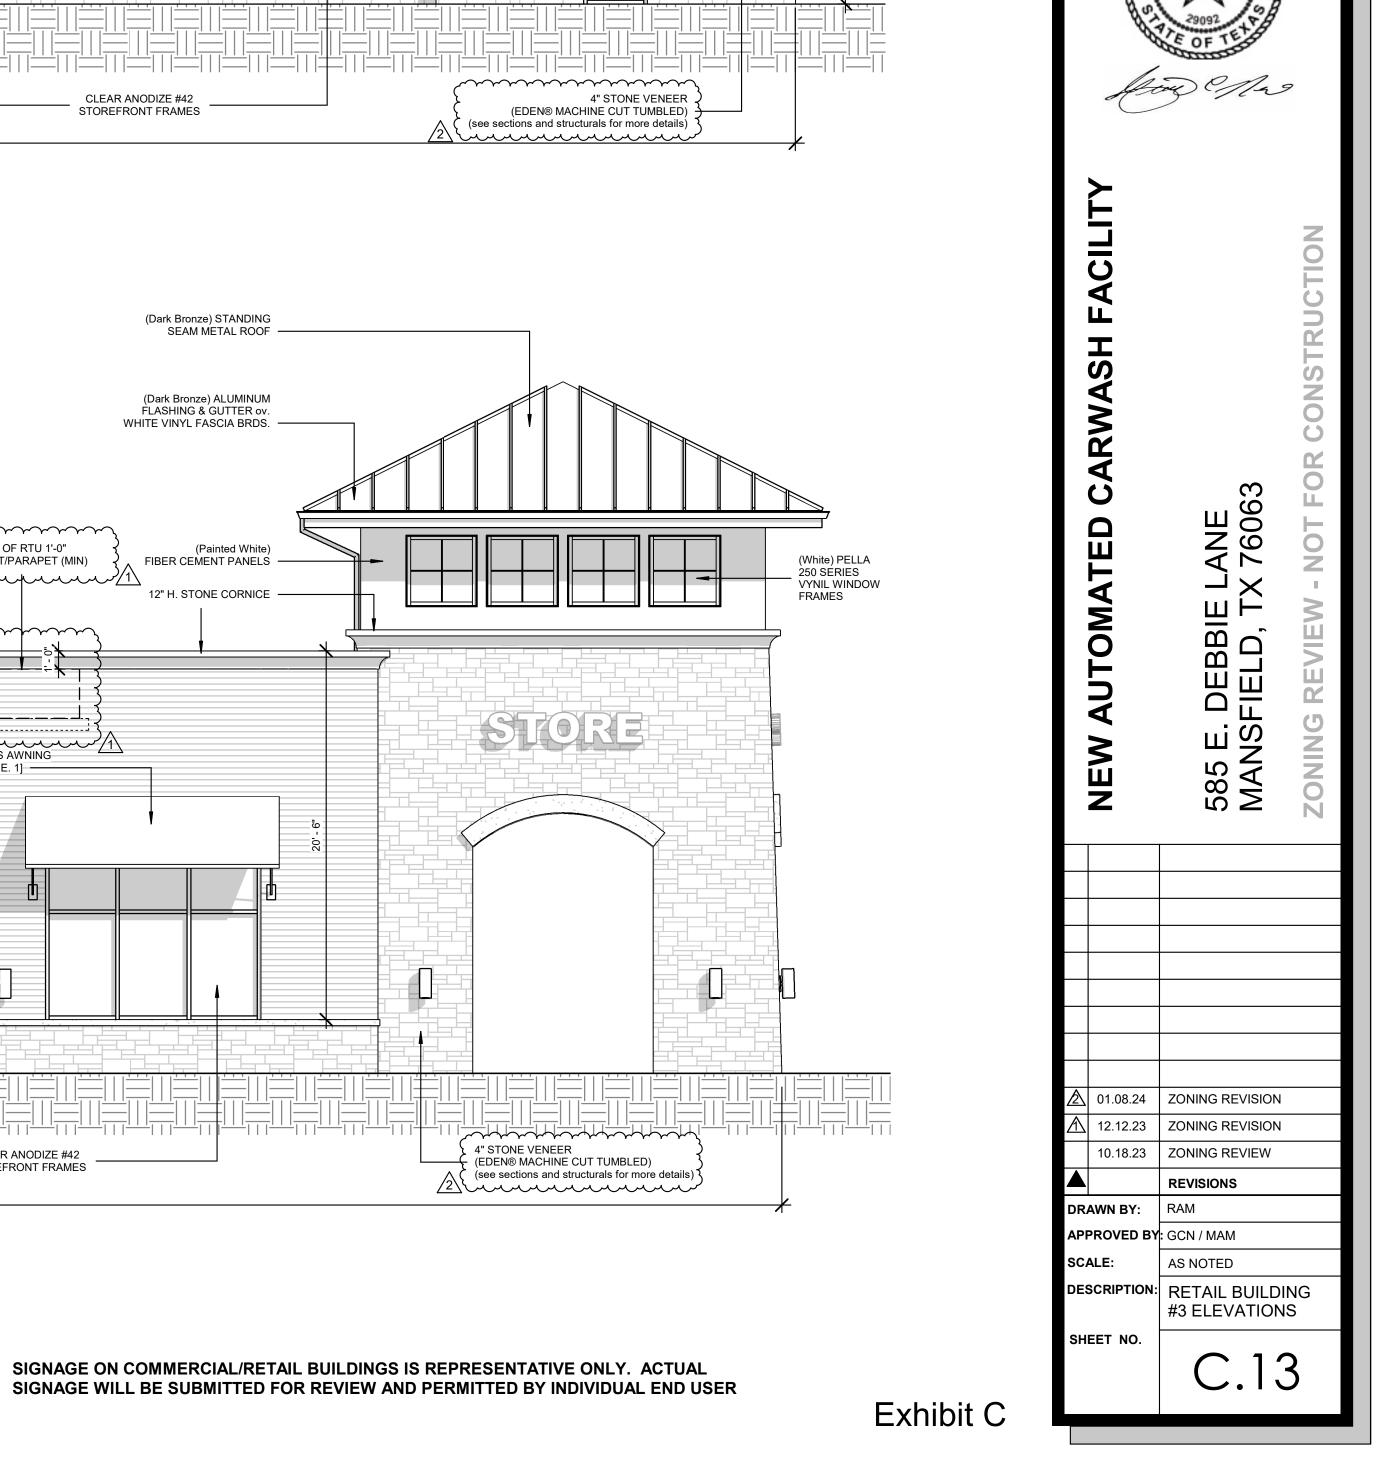

PROJECT # 2334


12/06/23

DATE:

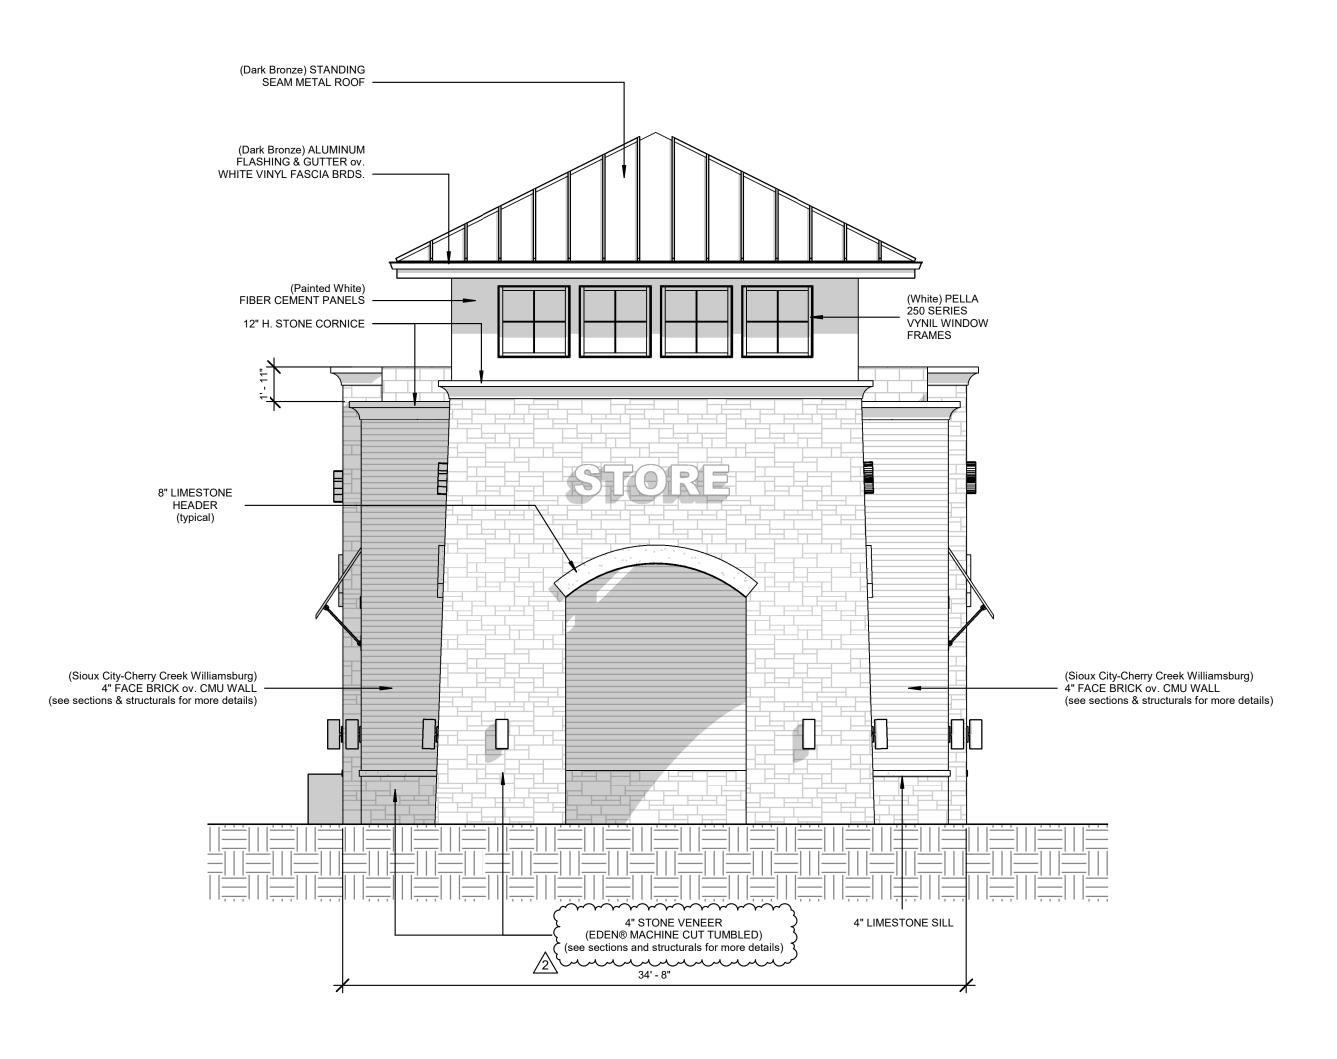

South Elevation. Proposed Retail Building #3.


SCALE: 3/16" = 1'-0"

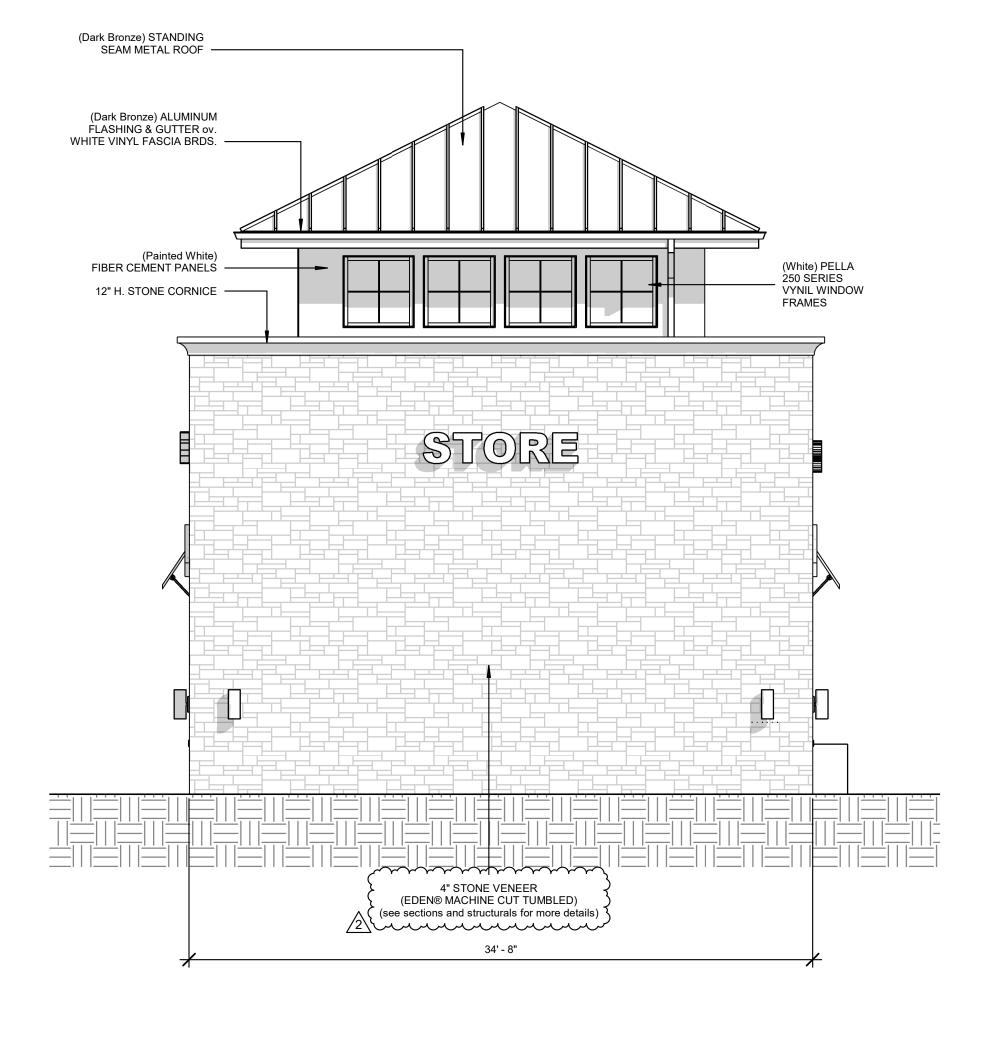

North Elevation. Proposed Retail Building #3.

2 24x36

C.14 SCALE: 3/16" = 1'-0"

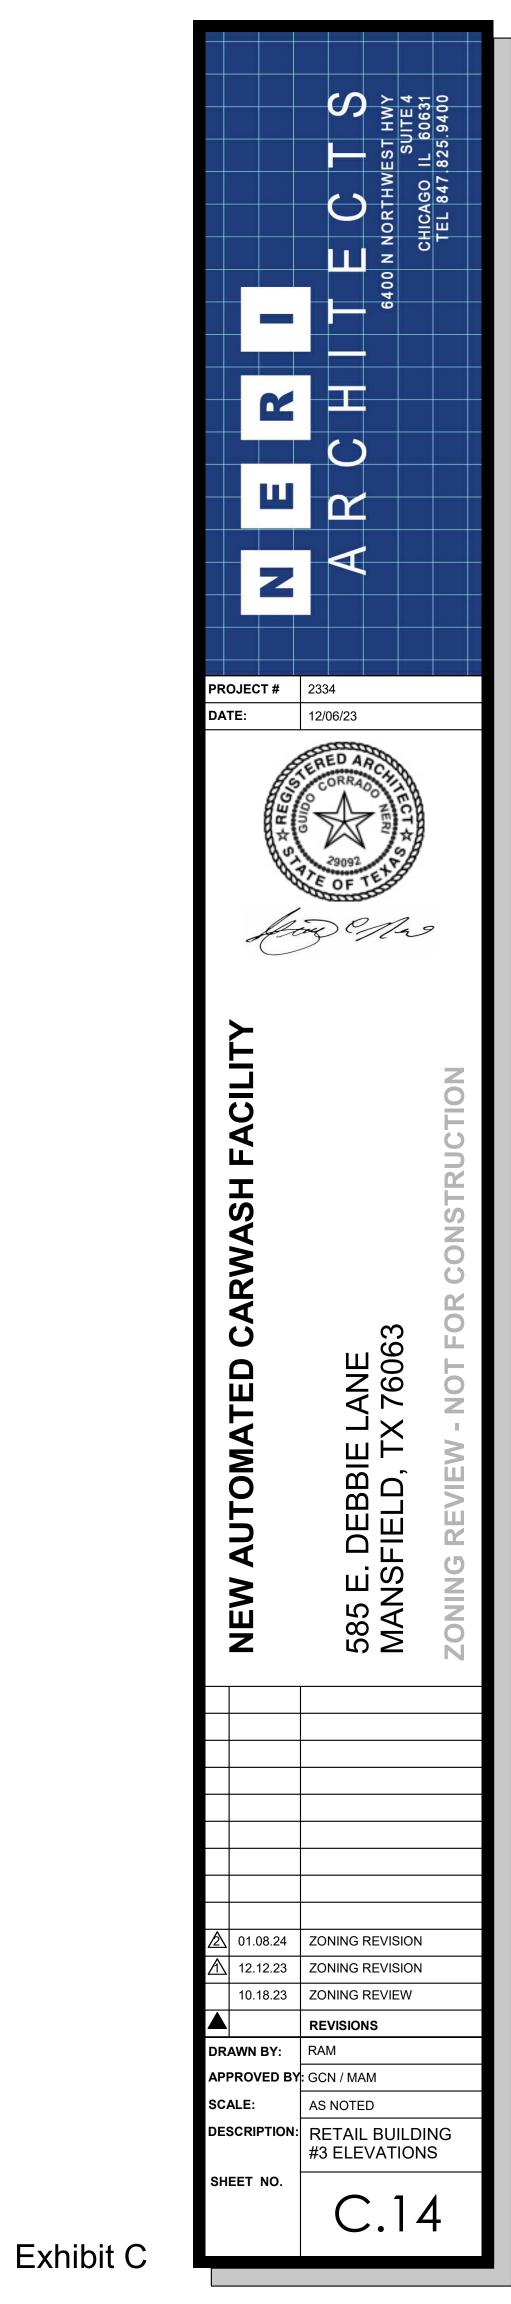

SIGNAGE ON COMMERCIAL/RETAIL BUILDINGS IS REPRESENTATIVE ONLY. ACTUAL SIGNAGE WILL BE SUBMITTED FOR REVIEW AND PERMITTED BY INDIVIDUAL END USER



4" STONE VENEER
(EDEN® MACHINE CUT TUMBLED)
(see sections and structurals for more details)

North Elevation. Proposed Retail Building #3 -

material exhibit
C.15 SCALE: 1/8" = 1'-0"

(Sioux City-Cherry Creek Williamsburg)

4" FACE BRICK ov. CMU WALL (see sections & structurals for more details)

- 4" LIMESTONE SILL

4" STONE VENEER


(EDEN® MACHINE CUT TUMBLED)

(see sections and structurals for more details)

South Elevation. Proposed Retail Building #3 -

3 material exhibit

C.15 SCALE: 1/8" = 1'-0"

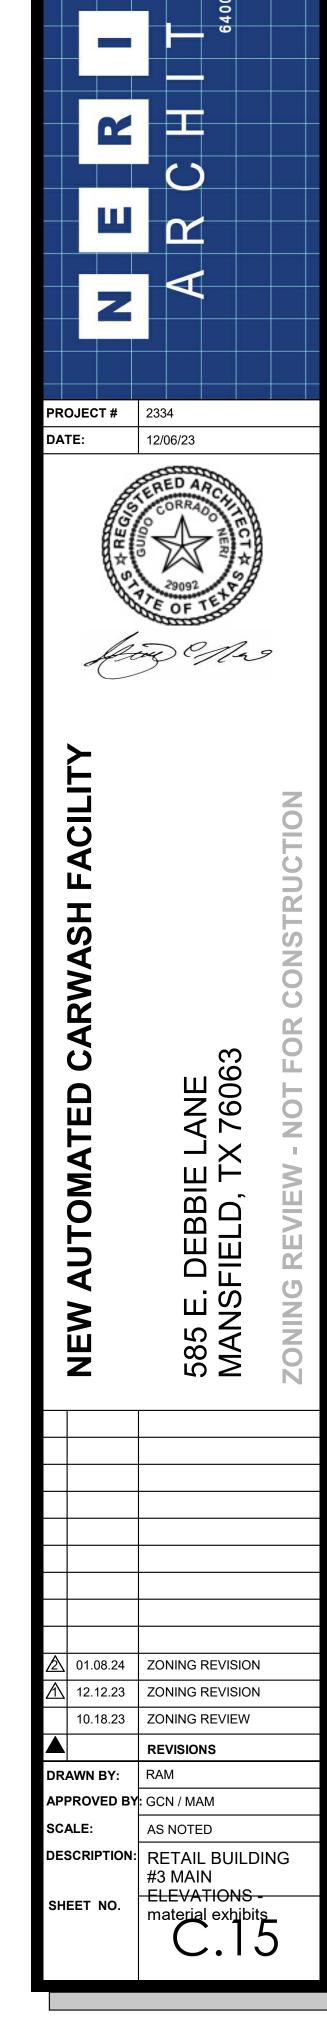











2 VIEW LOOKING NORTHWEST SCALE: 12" = 1'-0"



VIEW LOOKING SOUTHEAST

SCALE: 12" = 1'-0"









VIEW LOOKING SOUTH

SCALE: 12" = 1'-0"




2 VIEW LOOKING SOUTHWEST (CAR WASH)
SCALE: 12" = 1'-0"




VIEW LOOKING NORTHWEST (CAFE)


SCALE: 12" = 1'-0"


PROJECT # DATE:	
NEW AUTOMATED CARWASH FACILITY	585 E. DEBBIE LANE MANSFIELD, TX 76063 ZONING REVIEW - NOT FOR CONSTRUCTION
DRAWN BY: APPROVED E SCALE: DESCRIPTION	ZONING REVISION ZONING REVIEW REVISIONS RAM BY: GCN / MAM AS NOTED

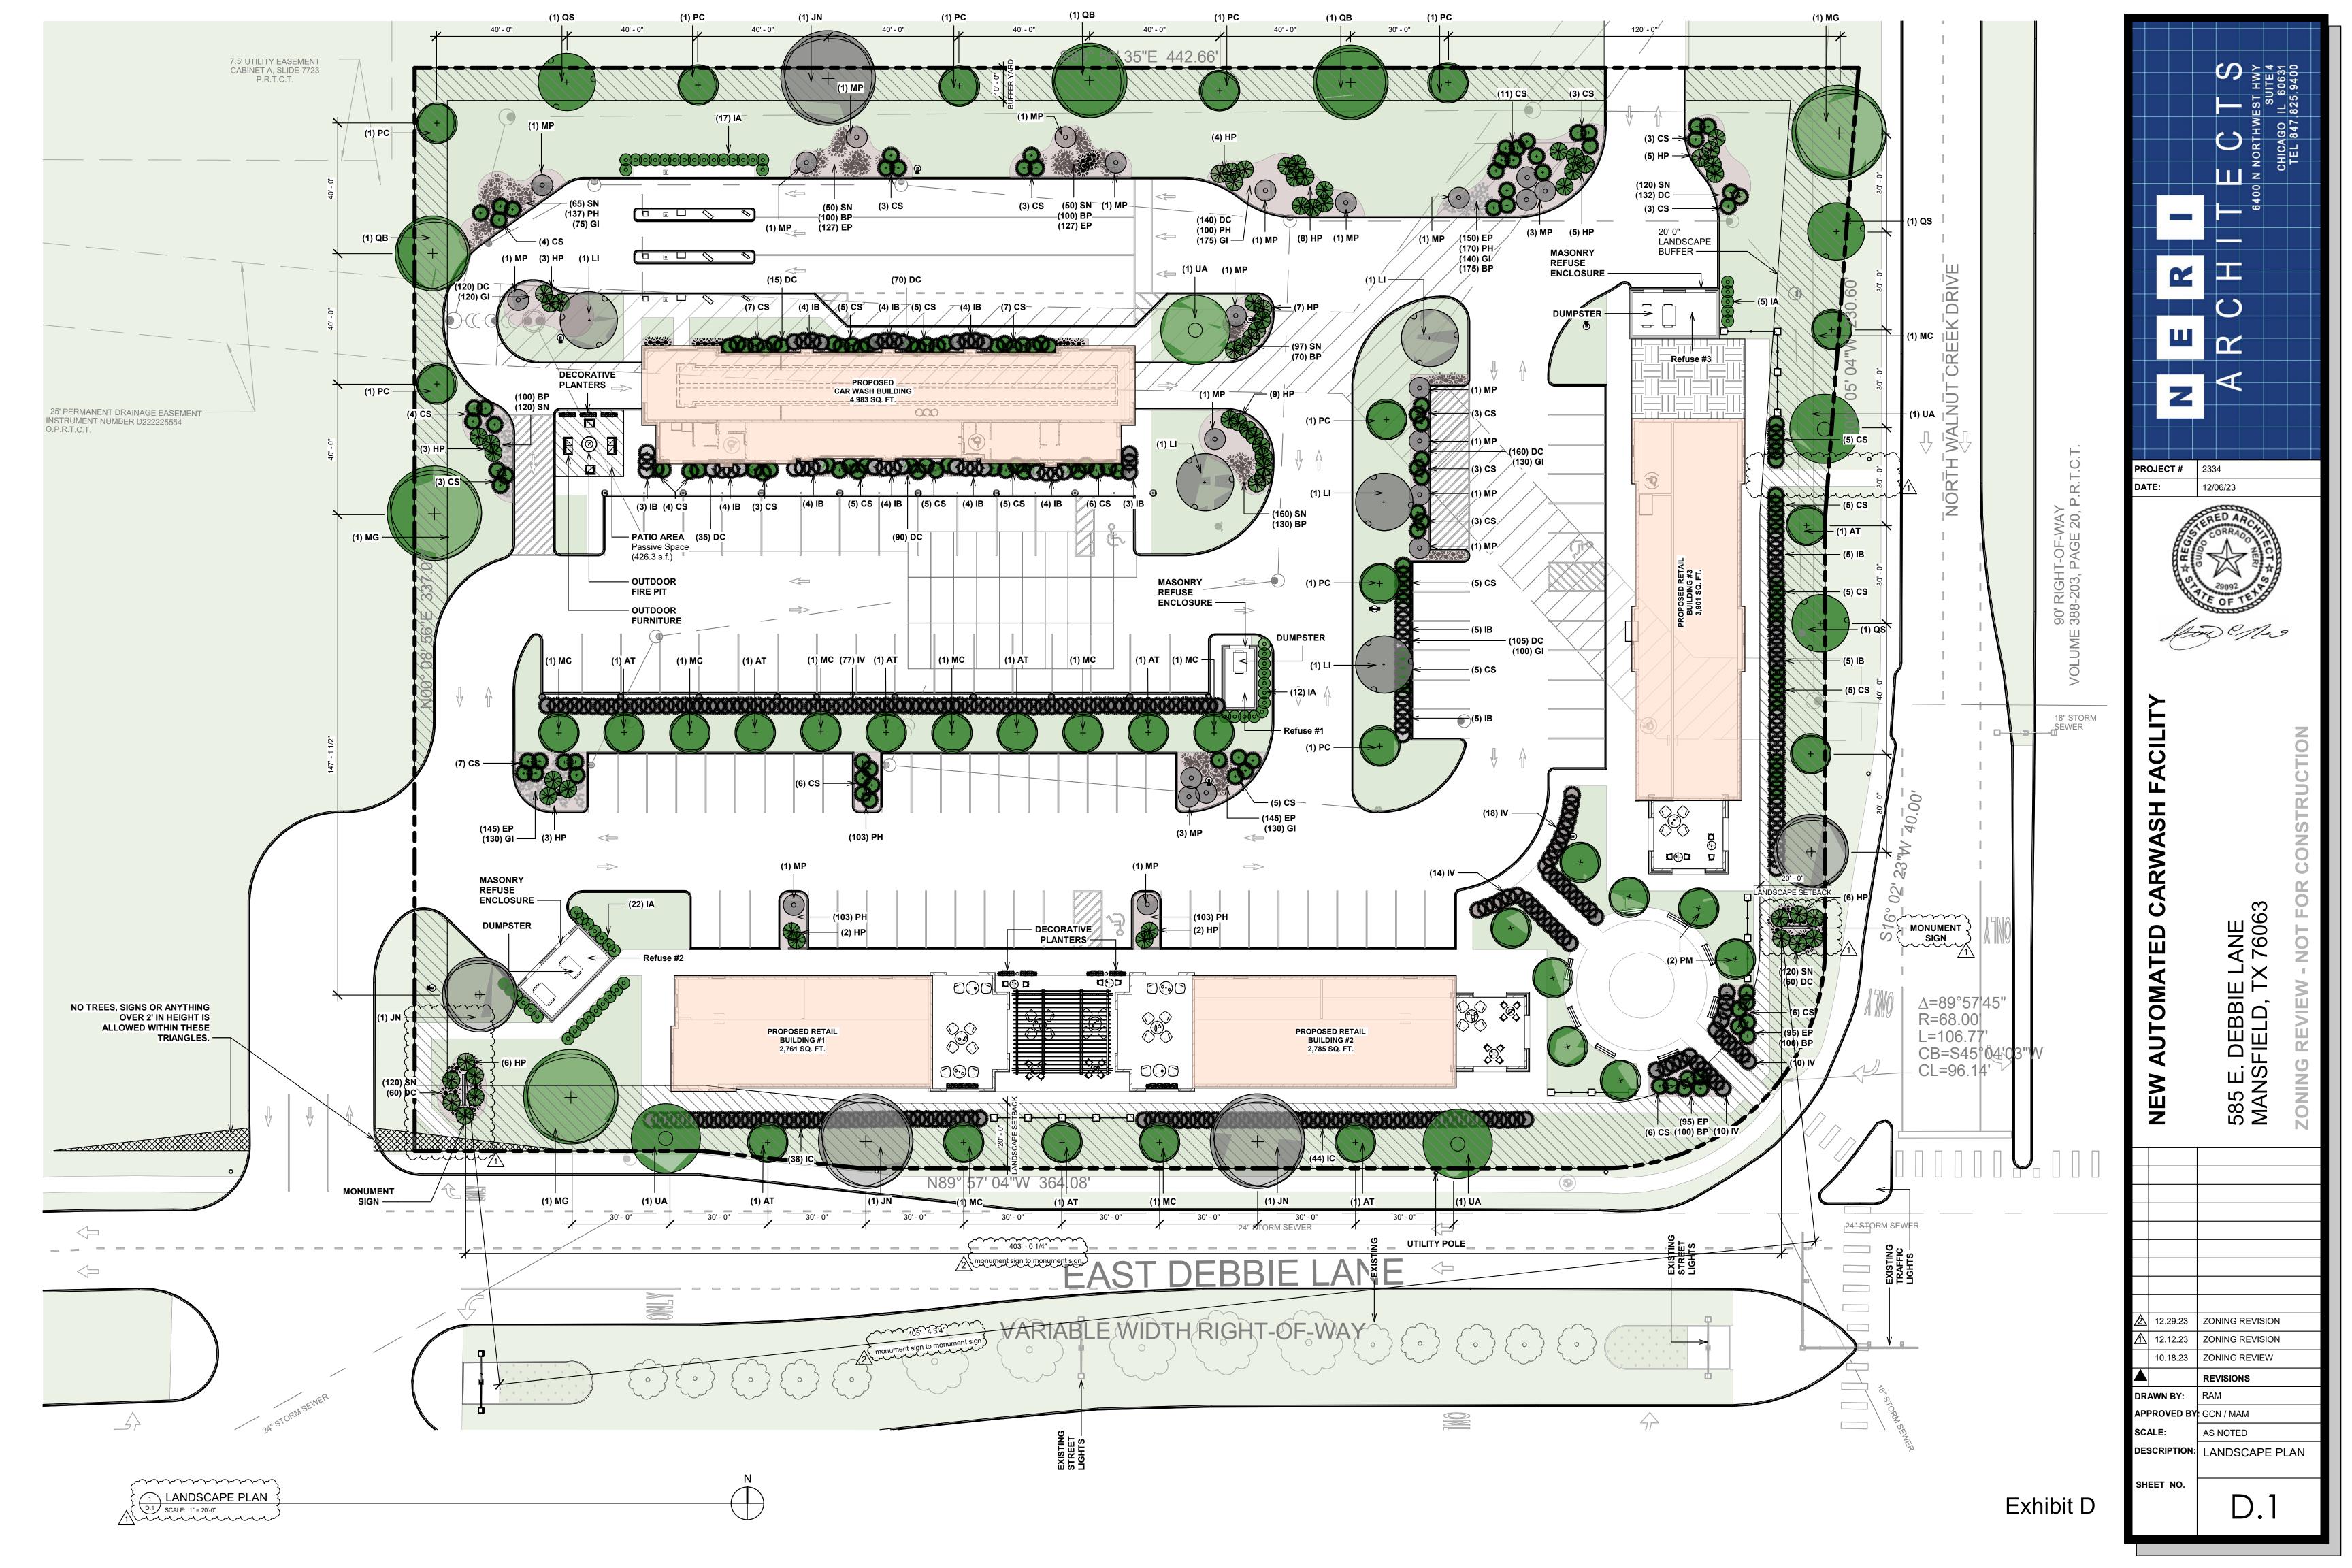

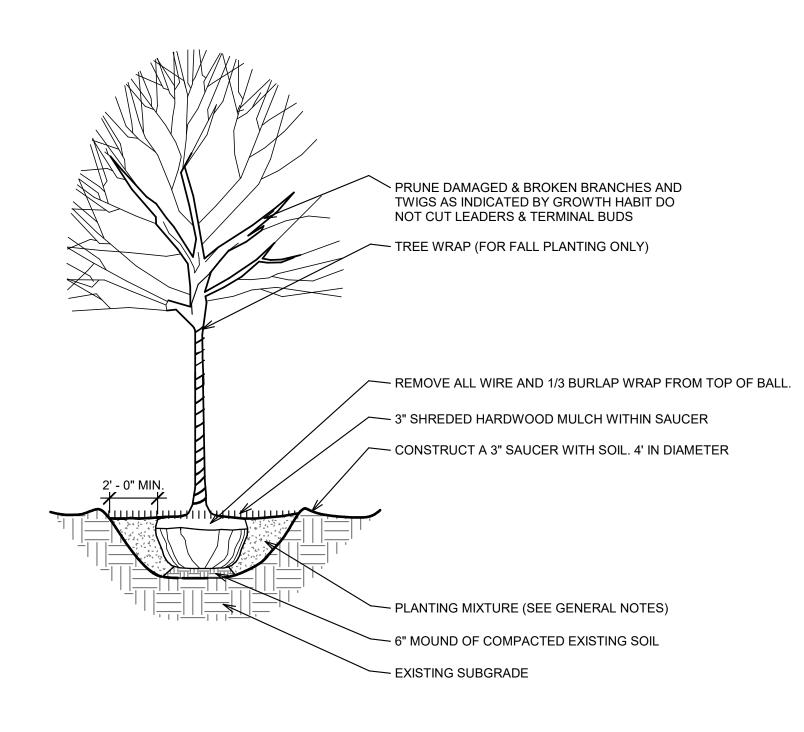

— PRUNE DAMAGED & BROKEN BRANCHES AND TWIGS AS INDICATED BY GROWTH HABIT DO NOT CUT LEADERS & TERMINAL BUDS SET TREE PLUMB IN CENTER OF PIT. - SET BALL AT LEVEL SO THAT TOP OF BALL IS AT FINISHED GRADE AFTER SETTLEMENT. NOMINAL PLANTING SOIL ON TOP OF BALL - REMOVE ALL WIRE AND 1/3 BURLAP WRAP FROM TOP OF BALL. — MIN. 3" SHREDDED HARDWOOD MULCH WITHIN SAUCER. — CONSTRUCT A 3" SAUCER WITH SOIL, 4" DIAMETER. - FINISHED GRADE PLANTING SOIL MIXTURE (SEE GENERAL NOTES) - 6" MOUND OF COMPACTED EXISTING SOIL — EXISTING SUBGRADE

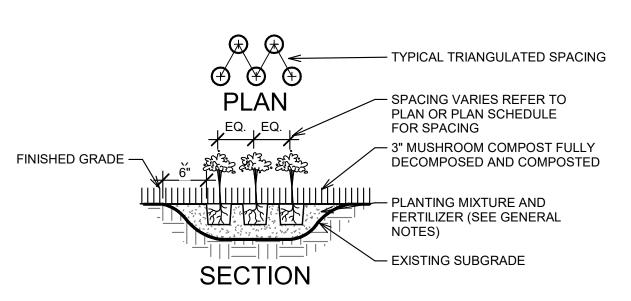

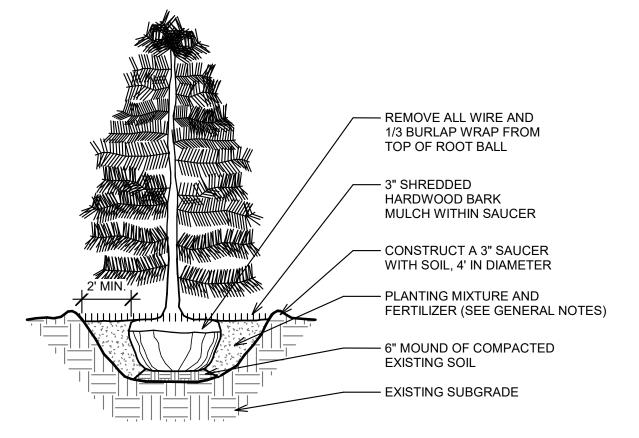

ORNAMENTAL TREE PLANTING DETAIL

SCALE: 1/4" = 1'-0"

PATED DEMISING PARTITION D.2 SCALE: 1/4" = 1'-0"

2 LARGE SHRUB PLANTING DETAIL
D.2 SCALE: 1/4" = 1'-0"

3 GROUND COVER PLANTING DETAIL
D.2 SCALE: 3/8" = 1'-0"

Planting Schedule

- 141	illing o	cneaule			
LEGEND	QUANT.	BOTANICAL NAME	COMMON NAME	MIN. SIZE	NOTES/SPECIAL CONDITIONS
CANOF	PY TREES (Min.	Size at planting 3" Caliper) - Parkway Tr	rees shall be max 40' apart	· · · · · · · · ·	· · · · · · · · · · · · · · · · · · ·
QB	3	Quercus Buckleyi	Oak, Texas Red	3" caliper / 8' ht	Mature height 40-60 ft.
MG	3	Magnolia Grandiflora	Magnolia, Southern	3" caliper / 8' ht	Mature height 60-80 ft.
UA	4	Ulmus Americana	American Elm 'Princeton'	3" caliper / 8' ht	Mature height 40-50 ft.
QS	3	Quercus Shumardi	Oak, Shumard	3" caliper / 8' ht	Mature height 60-80 ft.
JN	5	Juglans Nigra	Black Walnut	3" caliper / 8' ht	Mature height 70-80 ft.
ORNAN	MENTAL TREES	(Min. Size at planting 8' hgt. or 2.5" Cali	per)		
MC	10	Myrica Cerifera	Southern Wax Myrtle	2.5" caliper / 8' ht	Mature height 15-25 ft.
AT	9	Acer Truncatum	Shantung Maple	2.5" caliper / 8' ht	Mature height 25 ft.
P_{P}	mpriju.	Prunus Caroliniana	Cherry Laurel	2.5" caliper / 8' ht	Parkway Alt - used under power lines als
PM	8	Prunus mexicana	Mexican Plum	2.5" caliper / 8' ht	Mature height 15-30 ft.
LI	5	Lagerstroemia Indica	Crape Myrtle	2.5" caliper / 8' ht	Mature height 20-30 ft.
EVERG	GREEN SHRUBS (All Hedges to be maintained and kept b	elow @ max. 3'-0" tall))		
IB	71	Ilex Burfordii 'nana'	Dwarf Burford Holly	30" spr. / 24" ht	
MP	23	Myrica Pusilla	Dwarf Wax Myrtle	30" spr. / 24" ht	
IA	56	llex x Attenuata 'Foster'	Foster Holly	30" spr. / 24" ht	
IC	82	llex cornuta 'Rotunda'	Dwarf Chinese Holly	30" spr. / 24" ht	
IV	129	Ilex vomitoria 'nana'	Dwarf Yaupon	30" spr. / 24" ht	
DECID	UOUS SHRUBS	- (Height at Time of planting dwarf shrub	os – 18 inches / shrubs – 26 inches)	•	
CS	163	Cordateria Selloana	Pampas Grass	30" spr. / 24" ht	
HP	63	Hesperaloe Parvifolia	Red Yucca	30" spr. / 24" ht	
PEREI	NNIALS, GROUNE	OCOVERS - (plants in mulch beds)			
SN	902	Salvia Nemorosa 'Marcus'	Marcus Dwarf Blue Salvia	30" spr. / 1gal. pots	perennials
DC	987	Delosperma Cooperi	Jewel of Desert® Peridot Ice Plant	18" spread / 2"pots	perennials
	884	Echinacea Purpurea	PowWow® White Echinacea	18" spread / 2"pots	perennials
Gl	1000	Geranium Ibericum	Johnson's Blue Geranium	18" spread / 2"pots	perennials
ВР	875	Bellis Perennis	Daisies	18" spread / 2"pots	perennials
PH	716	Petunia x Hybrida	Petunia	18" spread / 2"pots	perennials

	SUMMARY CHART – BUFFER YARDS/SETBACKS						
Location of Buffer Yard or Setback	Required/ Provided	<u>Length</u>	Buffer yard or Setback Width/Type	Canopy Trees	Ornamental Trees	Shrubs	Screening Wall/Device Height & material
North	Required	442.66'	Buffer 10'		8	N/A	N/A
	Provided		10'	4	4	N/A	N/A
East	Required	270.60'	Setback 20'			N/A	
	Provided		20'	5	3	58	N/A
South	Required	364.08'	Buffer 20'		10	N/A	N/A
	Provided		20'	5	5	94	N/A
West	Required	337.07'	Setback 10'		5	N/A	N/A
	Provided		10'	3	2	N/A	N/A
*Note any credi a.	ts in calculations:				•		•
Other comment	s:						

SUMMARY CHART – INTERIOR PARKING L	OT LANDSCAPING
# Of Required Parking Spaces 7g (1 sp/150 s.f.)	96
# Of Provided Parking Spaces	90
# of Tree Islands Provided	N/A
*Note any credits in calculations: a.	
Other comments:	
1. 2.	

	Landscape Area (in Sq Ft)	% of Landscape Area	Canopy Trees	Ornamental Trees	Shrubs	Ground Cover (in Sq Ft)
~~~~	······	<del></del>	<del></del>	<del></del>	~~~	·
Required	50,649.71 Sq Ft	34.85%	18	41	N/A	N/A
Provided					584	10,429.00 Sq Ft
*Note any credits a.	in calculations:					
Other comments:						
2. 3.						

uth	Required	364.08'	Buffer 20'	1	0	N/A	N/A		Other
	Provided		20'	5	5	94	N/A		2.
est	Required	337.07'	Setback 10'		5	N/A	N/A	'	
	Provided		10'	3	2	N/A	N/A		
ote any credits	in calculations:								
her comments	:								

## GENERAL NOTES


- CONTRACTOR SHALL NOTIFY LANDSCAPE ARCHITECT /OWNER IMMEDIATELY OF ANY DISCREPANCIES, OBSTACLES AND/OR
- VERIFICATION OF DIMENSIONS AND GRADES, BOTH EXISTING AND PROPOSED, SHALL BE THE CONTRACTOR'S RESPONSIBILITY PRIOR TO COMMENCEMENT OF WORK. THE CONTRACTOR SHALL NOTIFY THE OWNER OF ANY
- ALL SURFACE DRAINAGE SHALL BE DIRECTED AWAY FROM STRUCTURES. SURFACE DRAINAGE SHALL BE DIRECTED TO EXISTING CATCH BASINS DESIGNATED FOR THE COLLECTION OF SURFACE RUN-OFF. CONTRACTOR SHALL NOTIFY OWNER OF ANY UNDESIRABLE DRAINAGE CONDITIONS AND RECOMMEND SUITABLE SOLUTIONS. WHERE NECESSARY TO ACHIEVE PROPER DRAINAGE, UNDER DRAINAGE FOR TREE PITS SHALL BE INSTALLED AT THE DIRECTION OF THE LANDSCAPE ARCHITECT.
- LANDSCAPE CONTRACTOR SHALL REPAIR IN KIND ALL AREAS DAMAGED AS A RESULT OF LANDSCAPE OPERATIONS. ALL TREE AND SHRUB BEDS TO RECEIVE A MINIMUM 3" OF SHREDDED HARDWOOD MULCH.
- ALL GROUND COVER/ PERENNIAL BEDS TO RECEIVE A MINIMUM 2" OF MUSHROOM COMPOST. SIZES SHOWN ON PLANTING PLAN ARE MINIMUM ACCEPTABLE SIZES.
- LANDSCAPE CONTRACTOR SHALL WARRANT ALL TREES, SHRUBS, VINES, GROUNDCOVERS AND PERENNIALS UNDER THIS CONTRACT WILL BE HEALTHY AND IN FLOURISHING CONDITION OF ACTIVE GROWTH ONE YEAR FROM DATE OF FINAL ACCEPTANCE
- SOIL TO BE USED FOR THE PLANTING MEDIUM FOR THE PROJECT SHALL BE FERTILE, WELL DRAINED, OF UNIFORM QUALITY, FREE OF STONES OVER 1" IN DIAMETER, STICKS, OILS, CHEMICALS, PLASTER, CONCRETE AND OTHER DELETERIOUS
- THE LANDSCAPE CONTRACTOR SHALL PREPARE PLANTING BEDS BY ADDING SOIL AMENDMENTS TO TOPSOIL MIX IN THE FOLLOWING QUANTITIES: TOPSOIL MIX FOR TREES AND SHRUBS SHALL BE THREE (3) PARTS TOPSOIL, ONE (1) PART PEAT, AND ONE (1) PART SAND. TOPSOIL MIX FOR PERENNIALS, BULBS, AND GROUND COVERS SHALL BE THREE (3) PARTS TOPSOIL, ONE (1) PART SAND AND TWO (2) PARTS DECOMPOSED MUSHROOM COMPOST. SOIL SHALL MEET THE FOLLWING REQUIREMENTS: SOIL COMPOSITION-45-77% SILT, 0-25% CLAY, 25-33% SAND; SOIL ACIDITY: Ph 6.0-7.0; SOIL ORGANIC
- CONTENT: THREE (3) TO FIVE (5) PERCENT. ALL PLANTS TO BE BALLED IN BURLAP OR CONTAINER GROWN AS SPECIFIED ON PLANTING PLAN. ALL PLASTIC ROOT
- WRAPPING MATERIAL AND METAL WIRE BASKETS SHALL BE REMOVED. LANDSCAPE CONTRACTOR SHALL STAKE THE LOCATION OF ALL TREES AND PLANTING BED LINES AND HAVE LAYOUT APPROVED BY LANDSCAPE ARCHITECT/OWNER PRIOR TO PLANTING.

WATER ALL PLANTS IMMEDIATELY AFTER PLANTING. FLOOD PLANTS TWICE DURING FIRST TWENTY-FOUR HOUR PERIOD

- AFTER PLANTING. ALL NEW AND TRANSPLANTED PLANTS TO BE SPRAYED WITH AN ANTIDESSICANT WITHIN TWENTY FOUR HOURS AFTER PLANTING. ANTI-TRANSPIRANT SHALL BE EQUAL TO "WILTPROOF."
  ALL MUD STALL BE REMOVED FROM ALL TIRES BEFORE LEAVING THE SITE AND ROADS SHALL BE KEPT CLEAR OF MUD AND
- ALL GRASS AREAS SHALL BE 6 INCHES OF TOPSOIL AND KENTUCKY BLUEGRASS SOD.

neat, orderly and live-grow weeding, and other such a	ving condition at all time activities common to the other such materials n	nes. This shall include mowing the maintenance of landscapin	e of all required landscaping in a h g, edging, pruning, fertilizing, irriga g. Landscaped areas shall be kep Plant materials that die shall be re
This irrigation system sha the Texas Commission or	ll adhere to the manufa n Environmental Qualit	acturers' specifications and th y (TEQ), or its successor age	at may include a drip irrigation system to the rules and regulations establishency, and the provisions set forth ingement and Drought Contingency
All underground irrigation	systems shall be desi	gned by an irrigator licensed l	by the State of Texas.
PASSIVE SPACE:			
Required 10% of building area		proposed	
10 /0 OI bullullig area			<del></del>
CAR WASH			
Building area:	4,983.0 s.f.		
Passive Space reqd:	498.3 s.f.	541.5 s.f.	
RETAIL BUILDING #1			
Building area:	2,761.0 s.f.		
Passive Space reqd:	276.1 s.f.	1280.0 s.f.	
RETAIL BUILDING #2			
Building area:	2,785.0 s.f.		
Passive Space reqd:	278.5 s.f.	904.8 s.f.	
RETAIL BUILDING #3			
Building area:	3,901.0 s.f.		
Passive Space reqd:	390.1 s.f.	1,751.2 s.f.	
PARKING LOT INTERNA	L LANDSCAPING		
Required		proposed	
1 Canopy/(10) spaces		· ·	
33 parking spaces	(3) Canopy trees		

NOTES

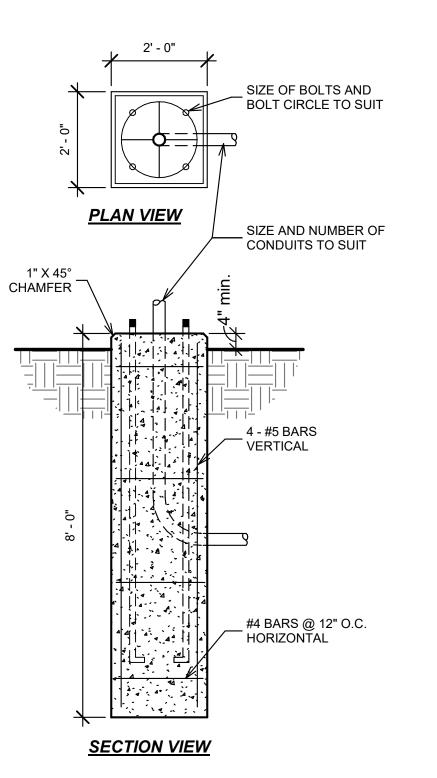

2 | 12.29.23 | ZONING REVISION 12.12.23 ZONING REVISION 10.18.23 ZONING REVIEW DRAWN BY: RAM APPROVED BY: GCN / MAM DESCRIPTION: LANDSCAPE SHEET NO.

**PROJECT #** 2334

12/06/23

BBIE LD, T

REVISIONS


AS NOTED

SCHEDULE

DATE:


CILIT

Exhibit D

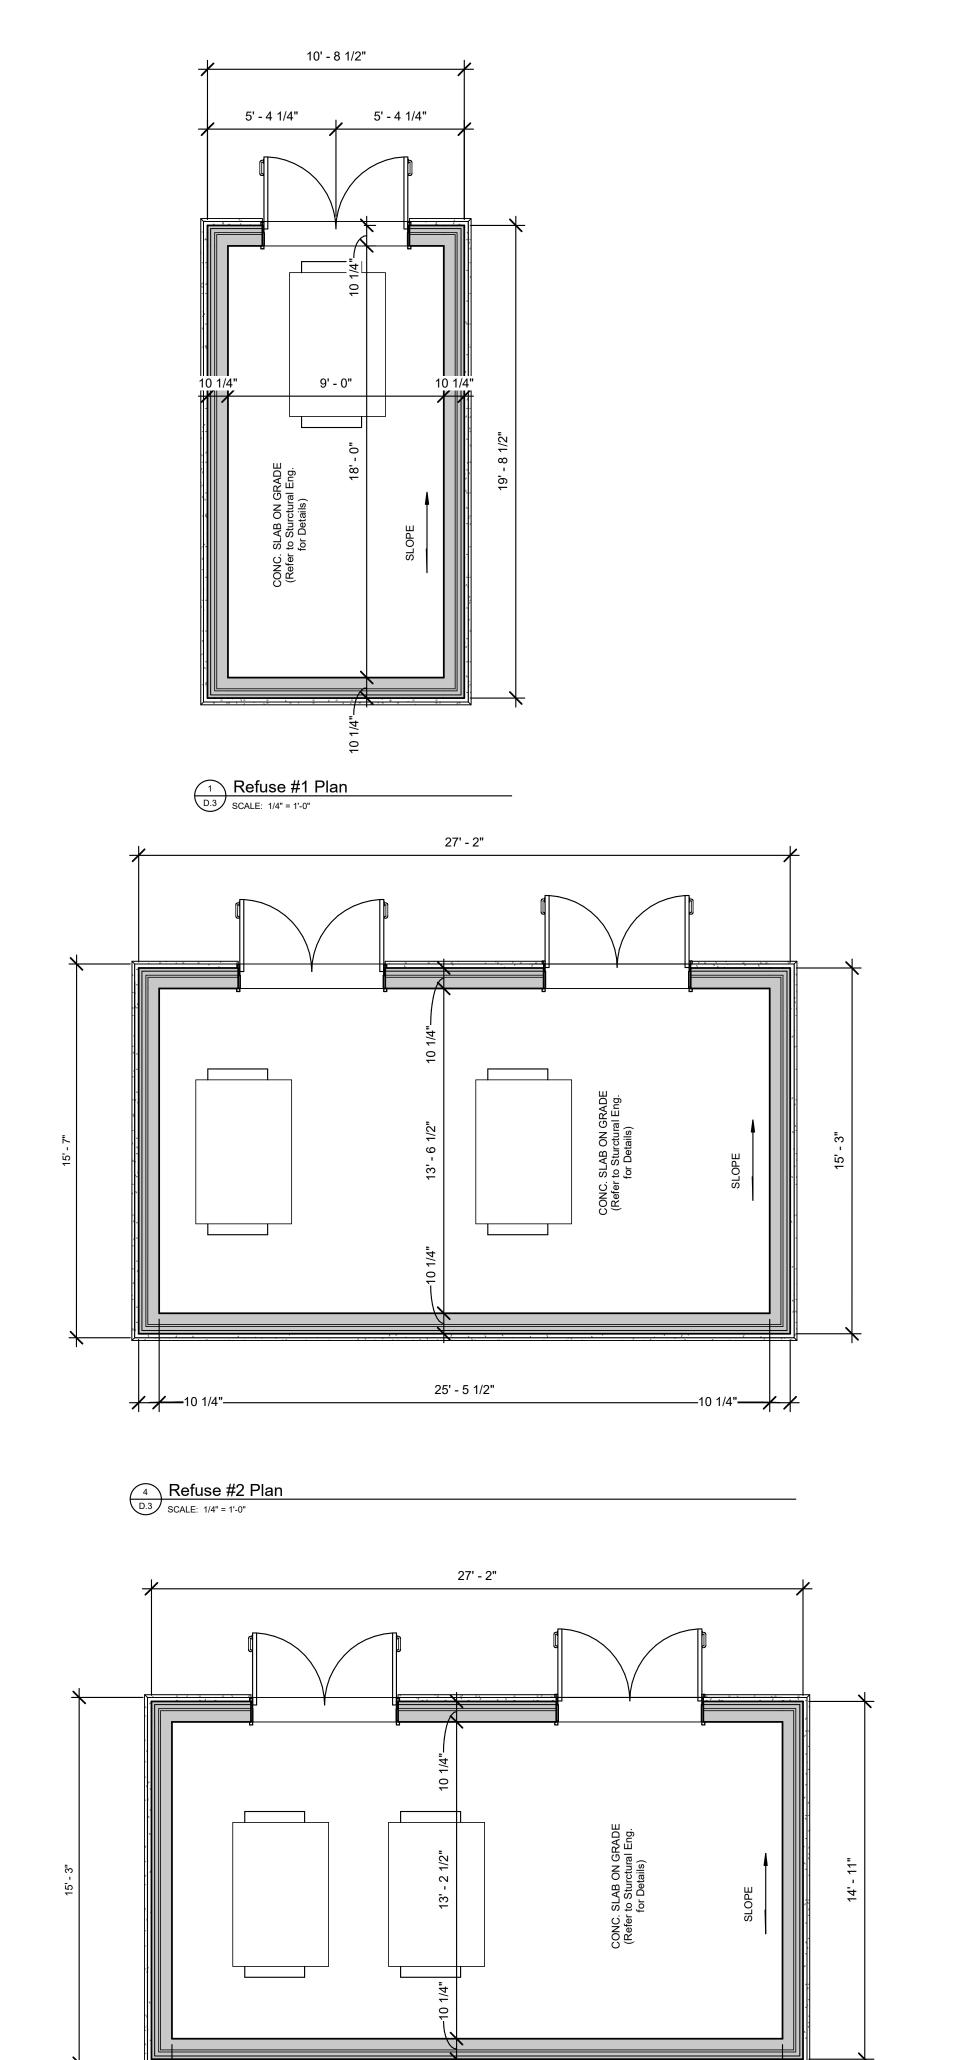


25' - 5 1/2"


7 Refuse #3 Plan
D.3 SCALE: 1/4" = 1'-0"

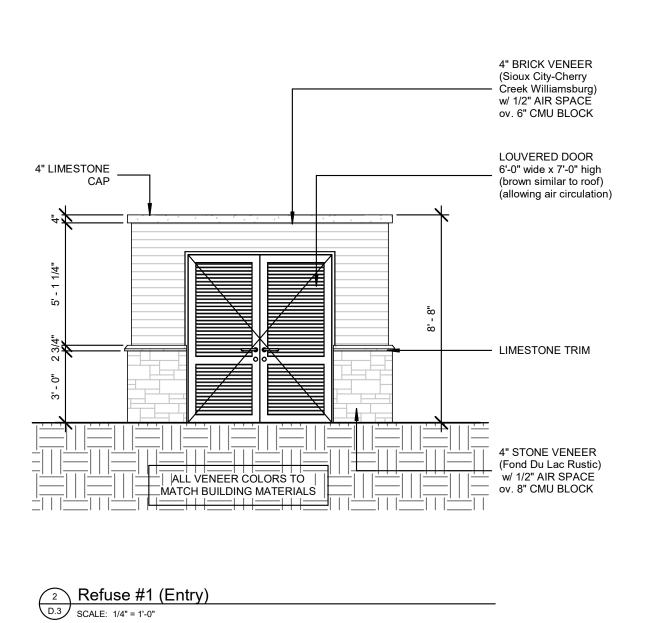



5 Refuse #2 (Entry)


SCALE: 1/4" = 1'-0"

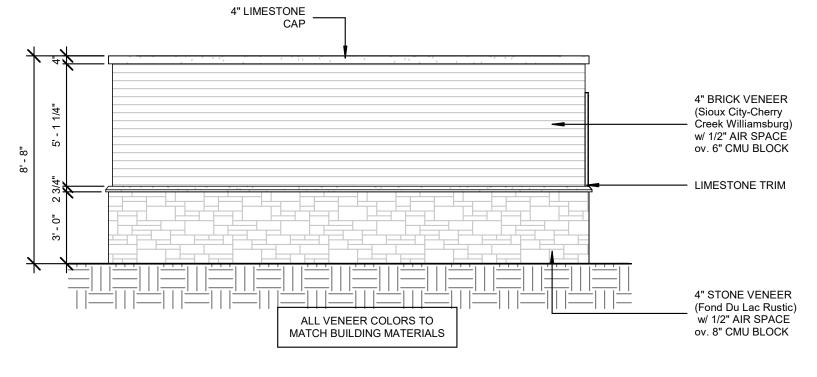


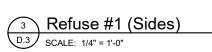


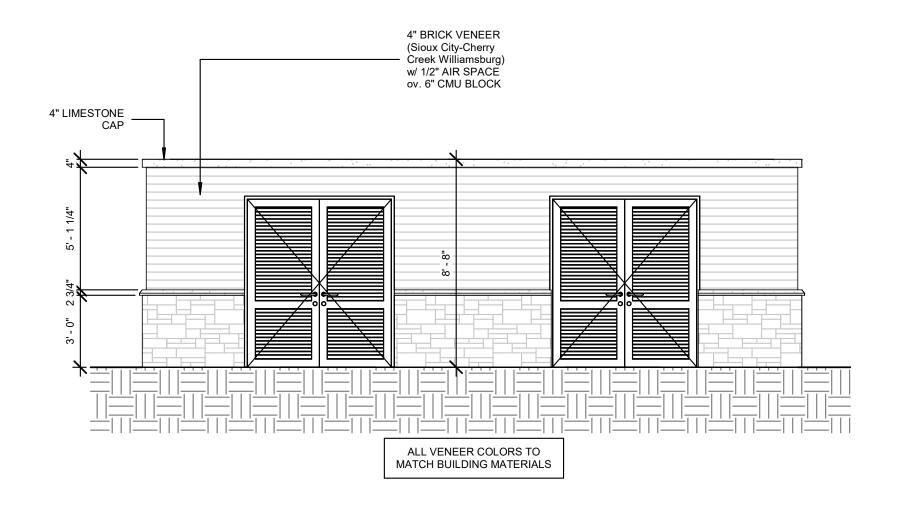

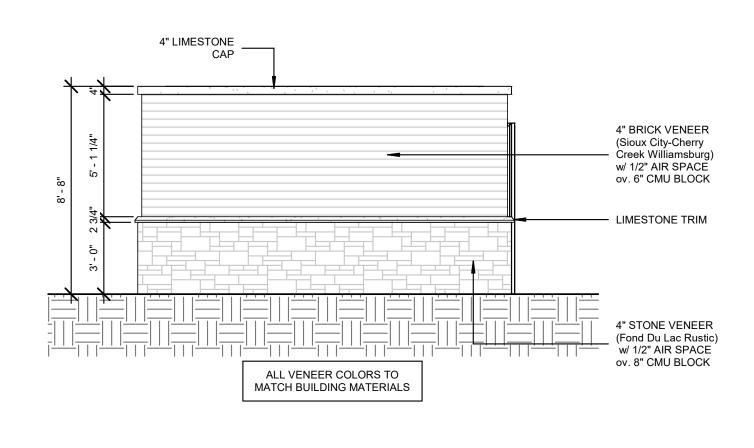

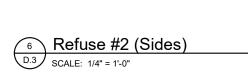

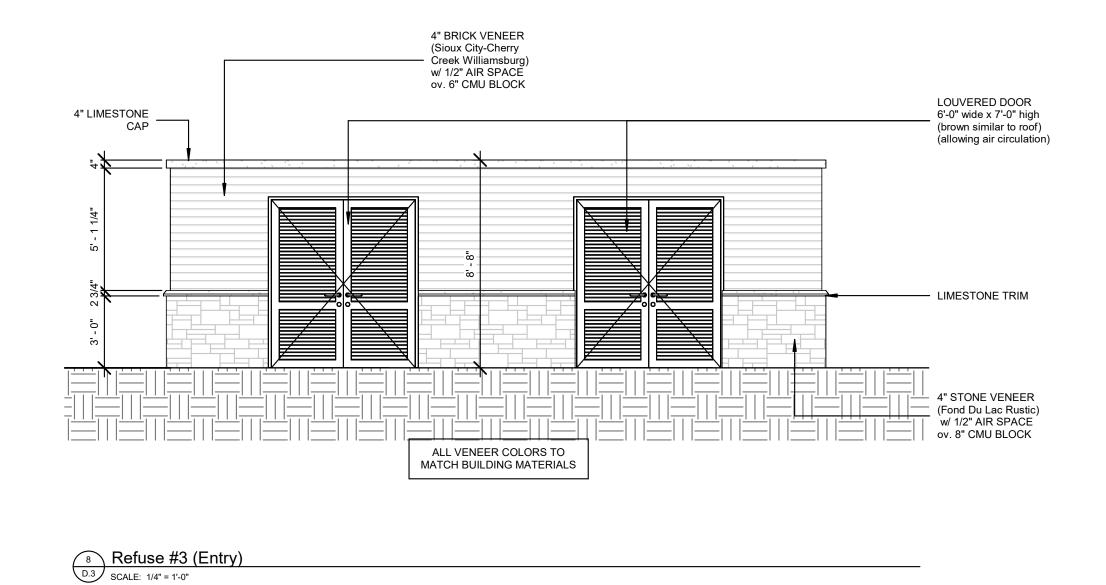

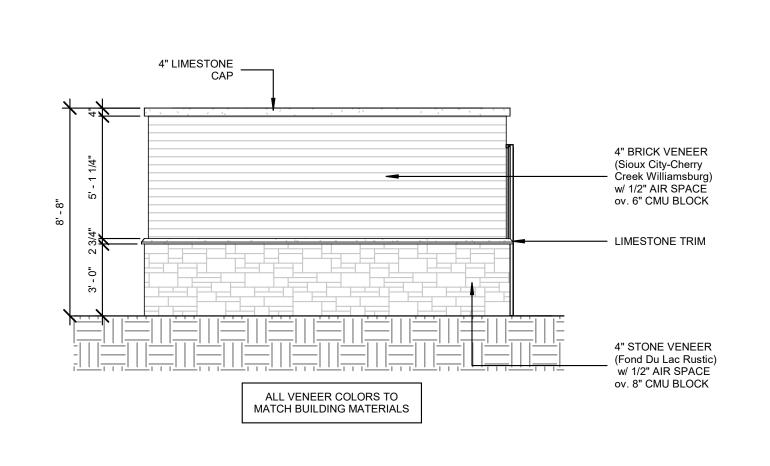

9 \	Refuse #3	(Sides)		
D.3 /	SCALE: 1/4" = 1'-0"	•		
<b>ン</b>	SCALE. 1/4 - 1-0			

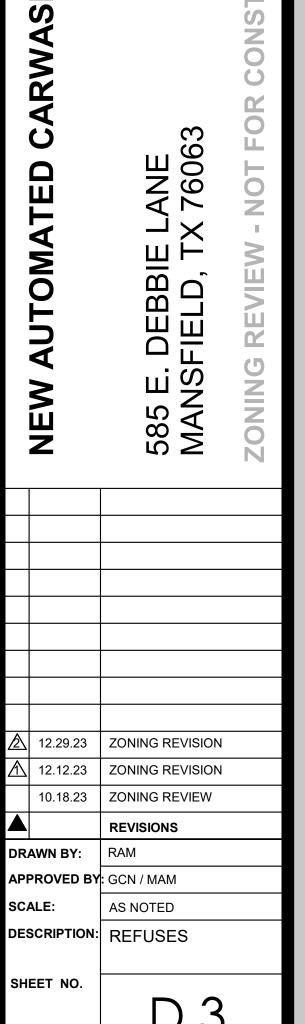



Exhibit D

**PROJECT #** 2334


12/06/23

DATE:

CILIT

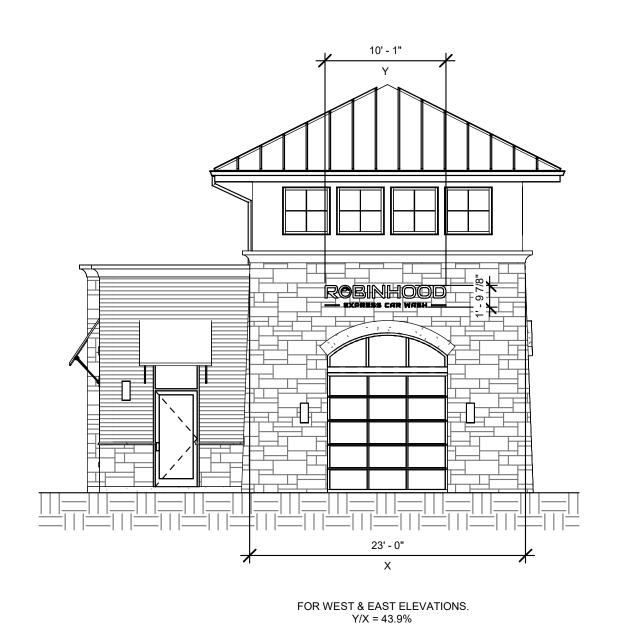


E.1 SCALE: 1/8" = 1'-0" (West similar)

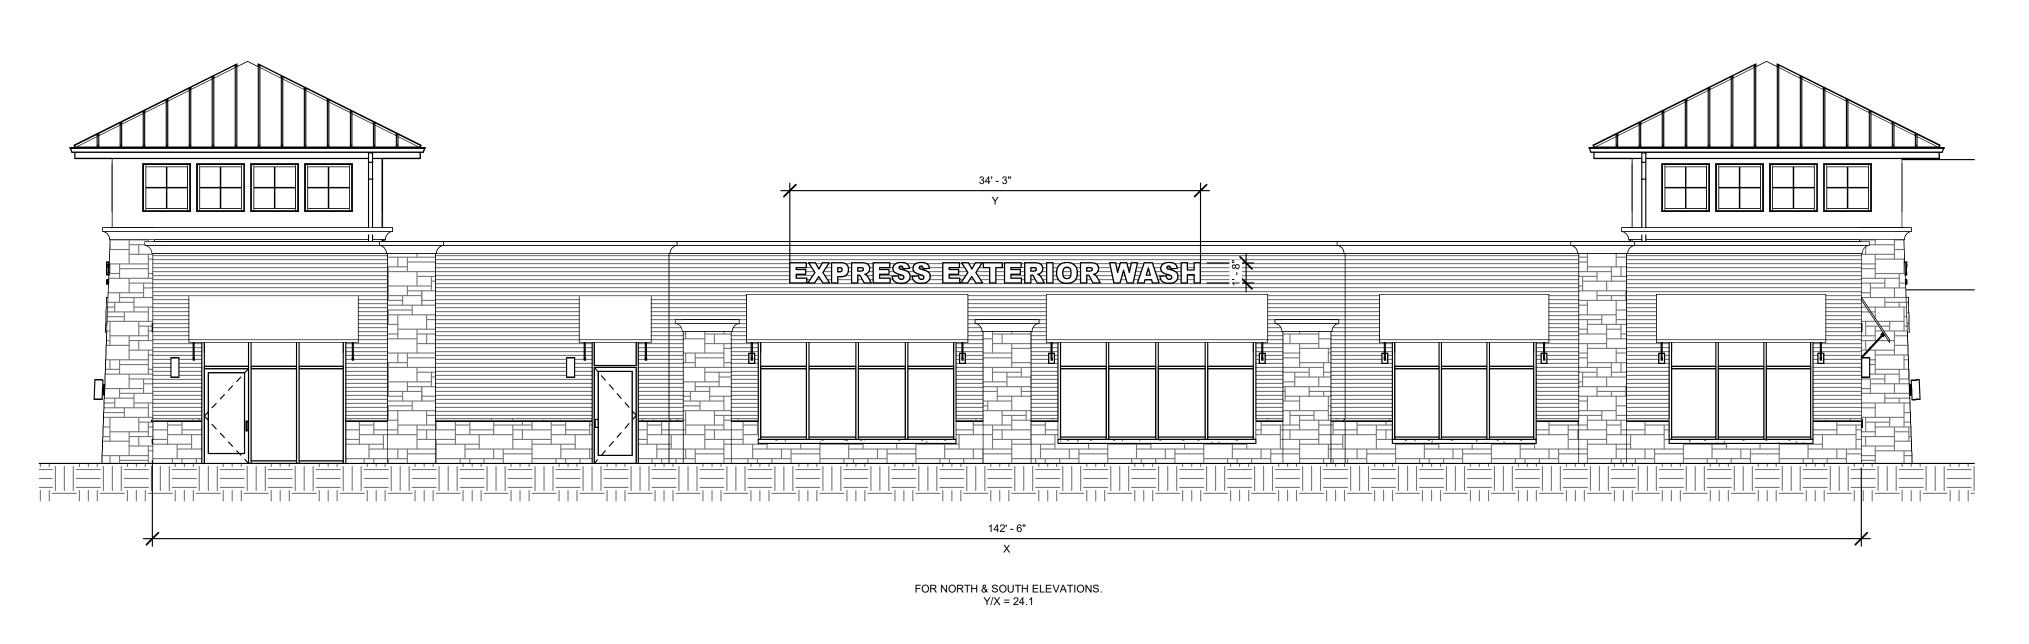

SOUTH ELEVATION (North similar)

SCALE: 1/8" = 1'-0"

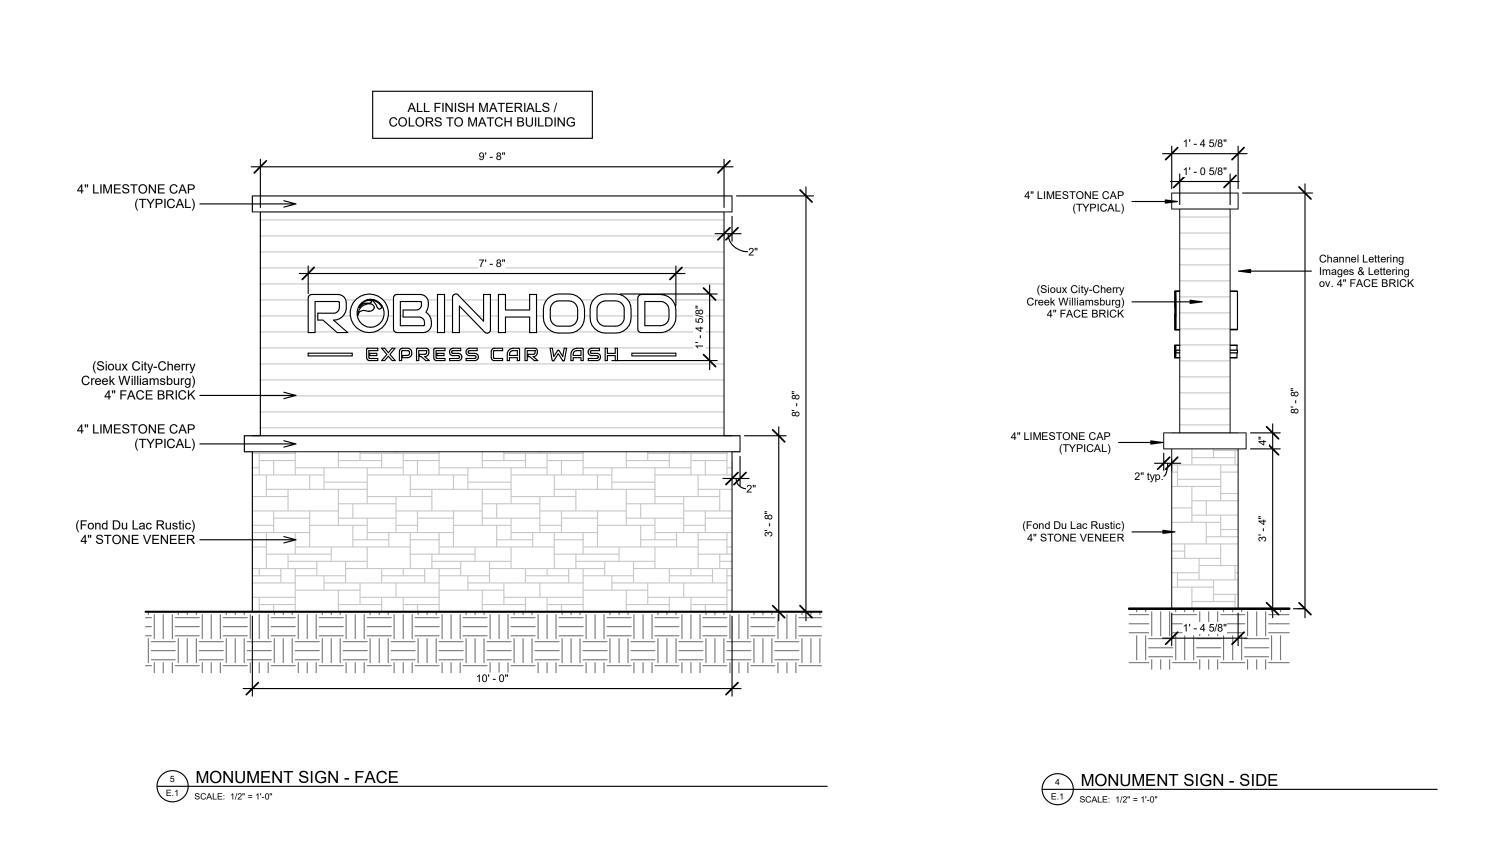


NOTES:

- BUILDING AND MONUMENT SIGNS ARE UNDER SEPARATE PERMIT
(Coordination required by GC and SUB-Contractor. Notify Architect of Any discrepancies)
- ALL SIGNS WILL COMPLY WITH THE REQUIREMENTS OF THE C-2
REGULATIONS

Exhibit E

PROJECT #	2334
A STATE OF THE PARTY OF THE PAR	12/06/23  RED ARCHITCH CORRADO VIETE PROPULATION CORRADO VIETE PROPULATION CORRADO VIETE CORRADO VIETA CORRADO VIE
NEW AUTOMATED CARWASH FACILITY	585 E. DEBBIE LANE MANSFIELD, TX 76063 ZONING REVIEW - NOT FOR CONSTRUCTION



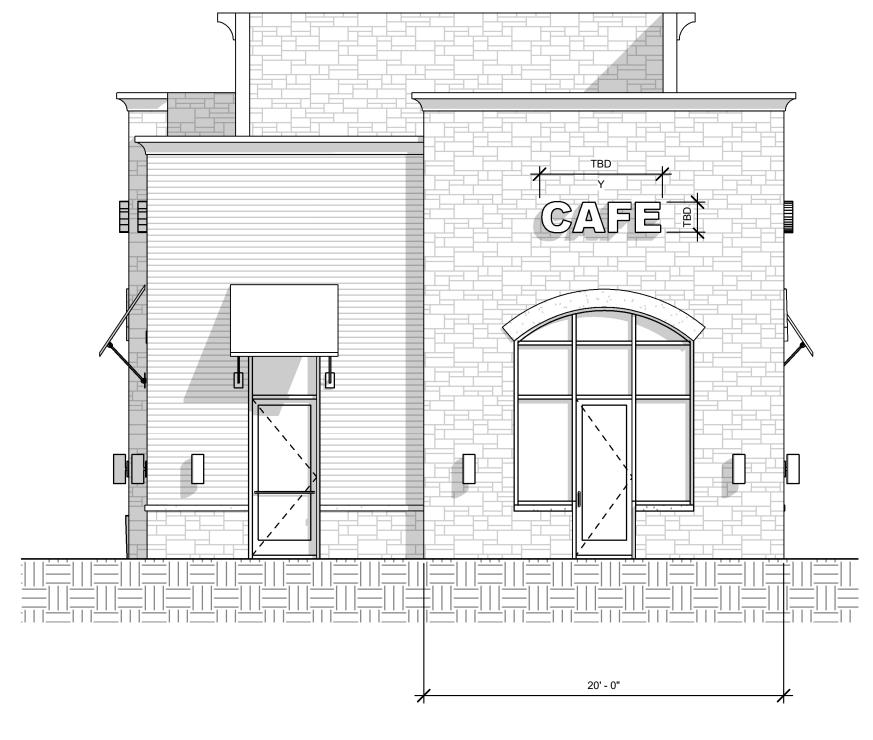

West Elevation. Proposed Retail Building #1.

SCALE: 3/16" = 1'-0"

North Elevation. Proposed Retail Building #1.

SCALE: 3/16" = 1'-0"

CATE L CATE L


South Elevation. Proposed Retail Building #1.

SCALE: 3/16" = 1'-0"

NOTES:
- ALL SIGNS WILL COMPLY WITH THE REQUIREMENTS OF THE C-2 REGULATIONS

**PROJECT #** 2334 DATE: 12/06/23 ACILITY CARWAS 585 E. DEBBIE LANE MANSFIELD, TX 76063 **NEW AUTOMATED** 12.12.23 ZONING REVISION 10.18.23 ZONING REVIEW **REVISIONS** DRAWN BY: RAM APPROVED BY: GCN / MAM AS NOTED DESCRIPTION: RETAIL BUILDING #1 SIGNAGE


SHEET NO.

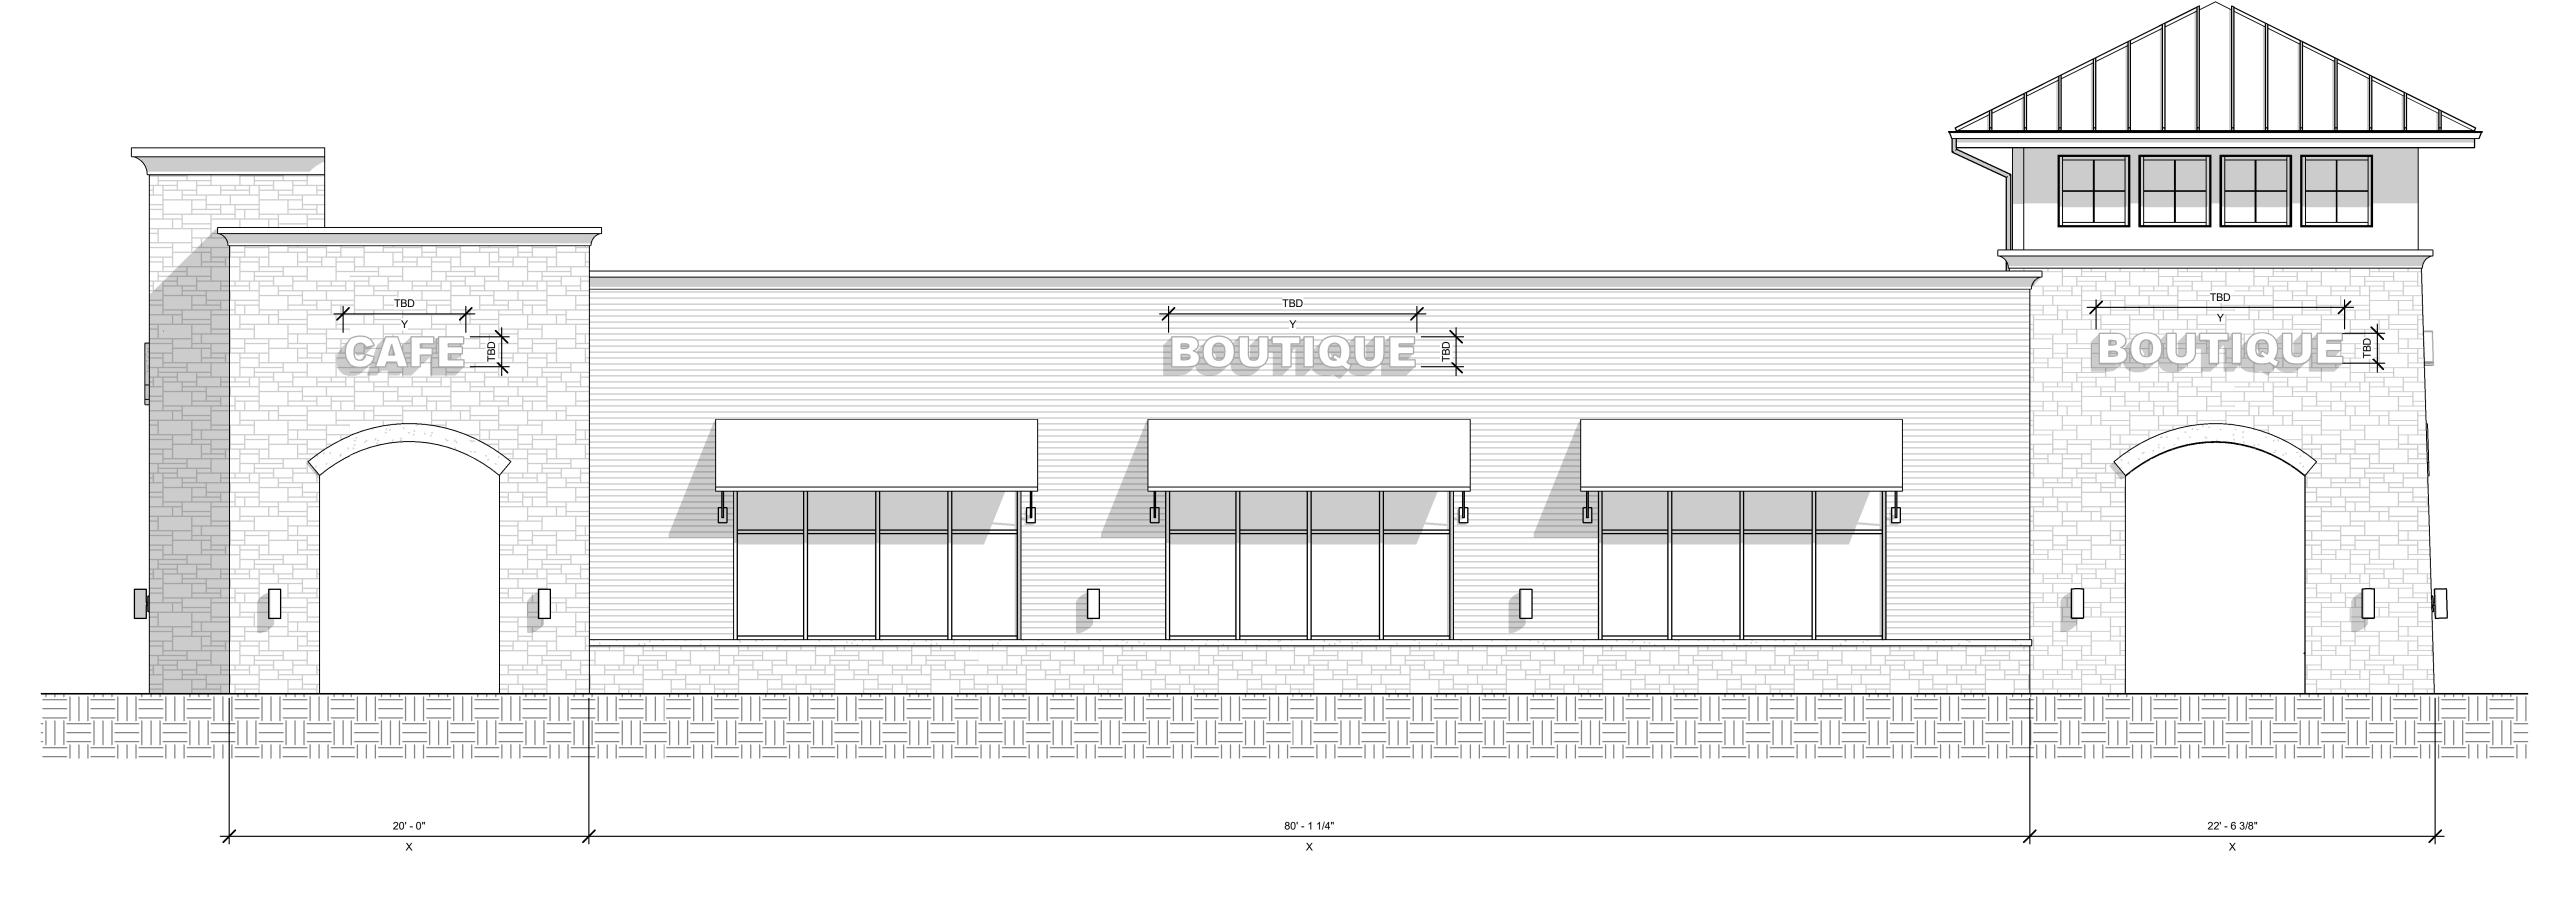

South Elevation. Proposed Retail Building #2

(North similar)


SCALE: 3/16" = 1'-0"

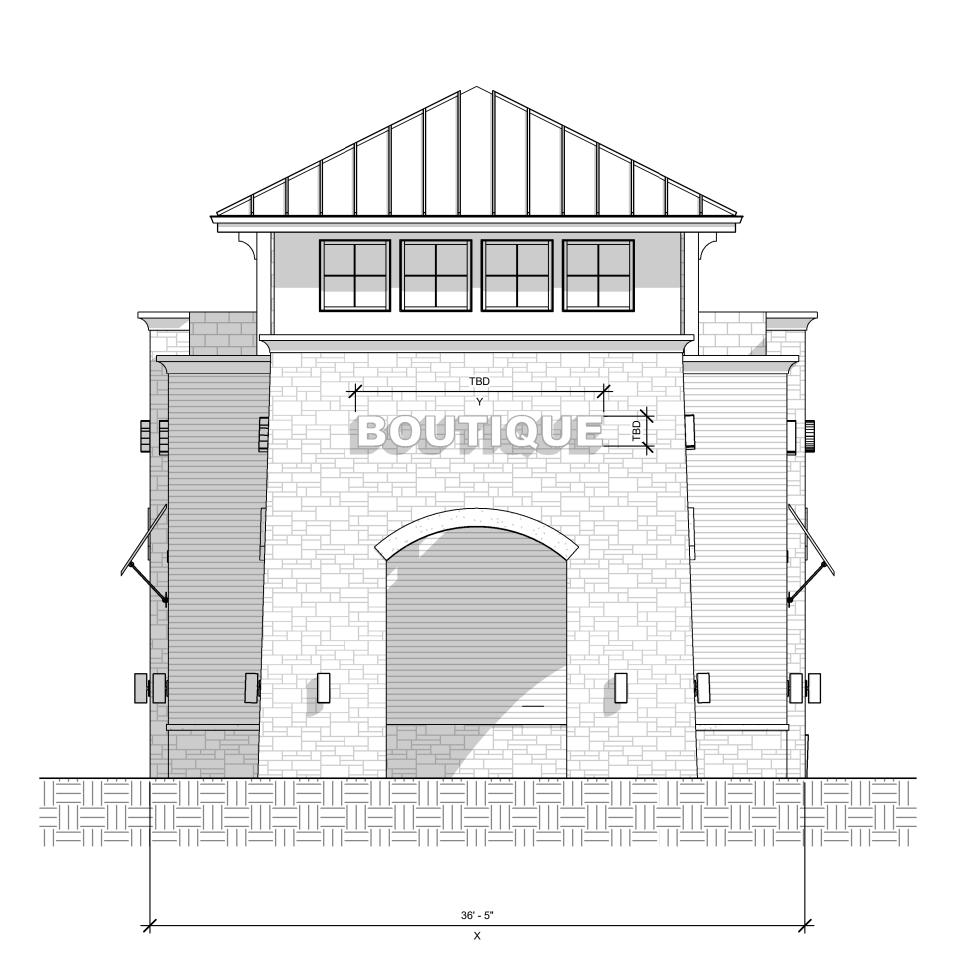

West Elevation. Proposed Retail Building #2

SCALE: 3/16" = 1'-0"

NOTES:
- ALL SIGNS WILL COMPLY WITH THE REQUIREMENTS OF THE C-2 REGULATIONS

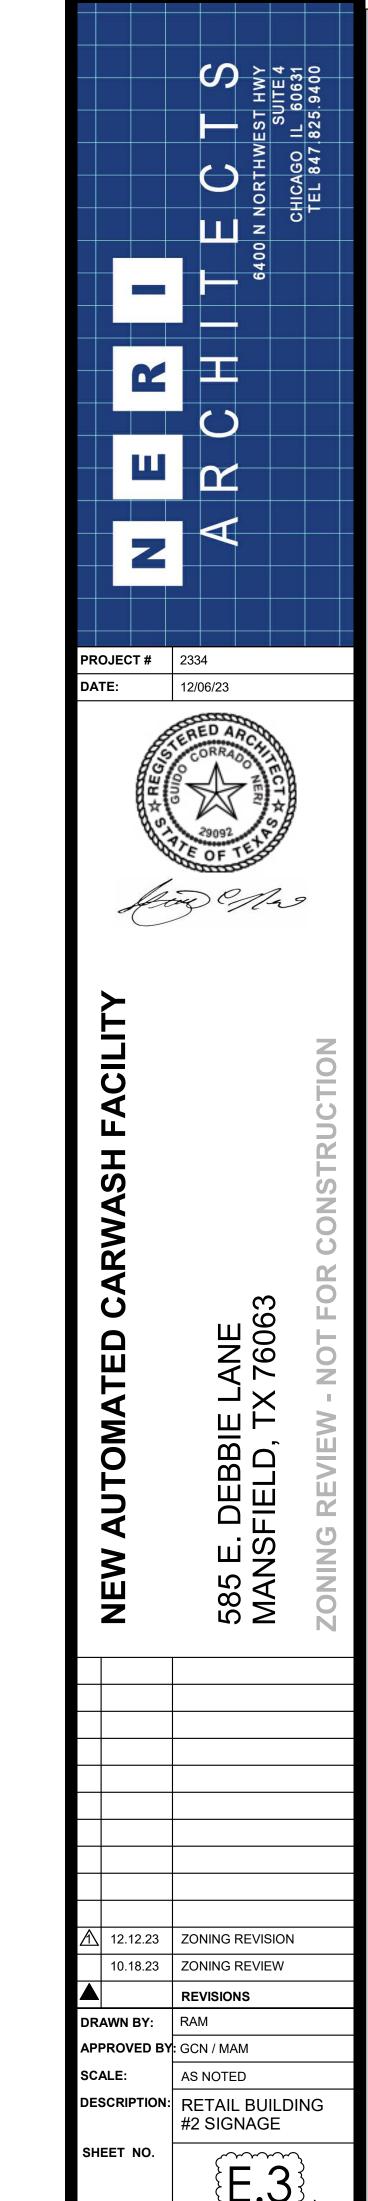





East Elevation. Proposed Retail Building #3.

(West similar)

SCALE: 3/16" = 1'-0"

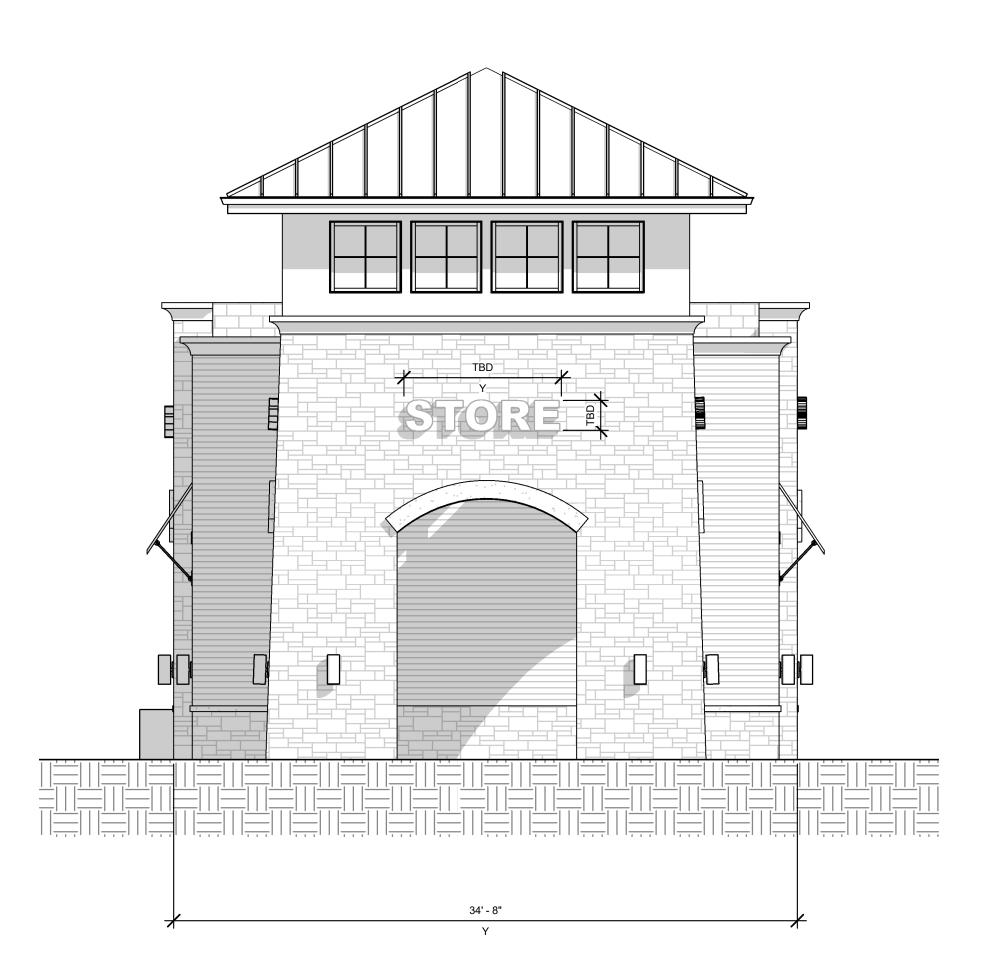



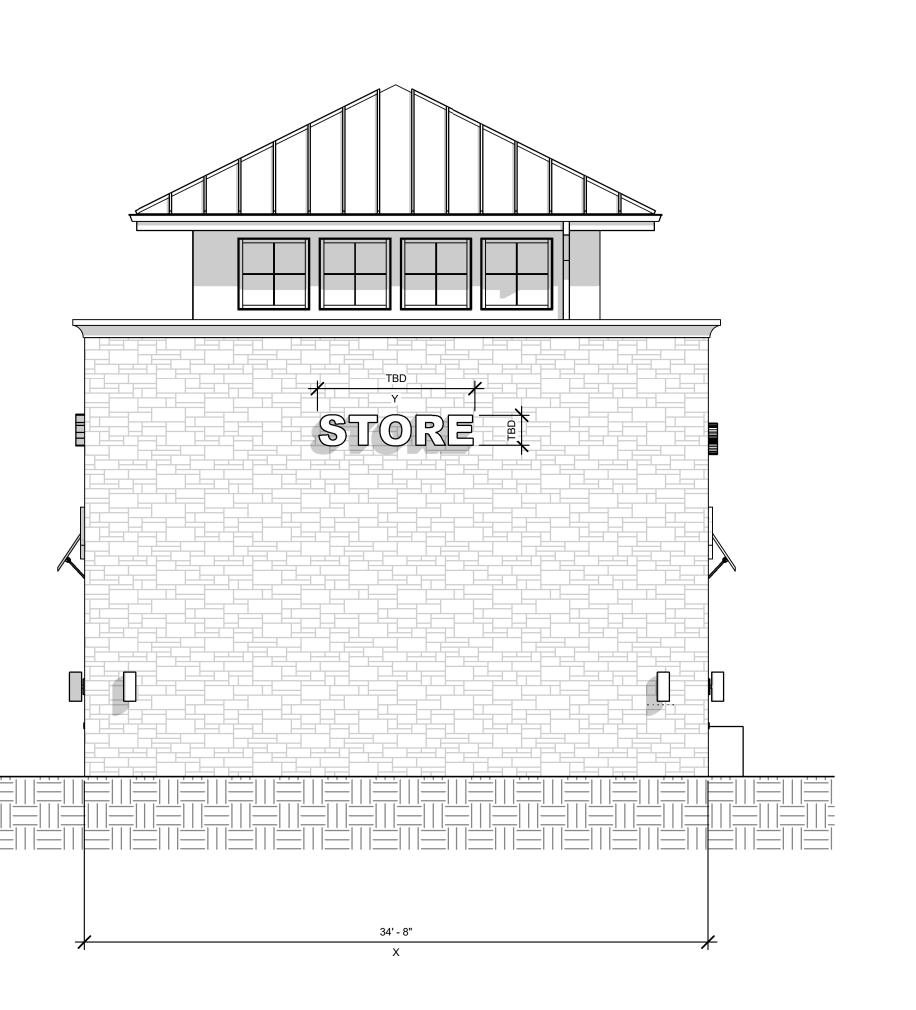

North Elevation. Proposed Retail Building #3.

SCALE: 3/16" = 1'-0"

NOTES:

- ALL SIGNS WILL COMPLY WITH THE REQUIREMENTS OF THE C-2 REGULATIONS

