


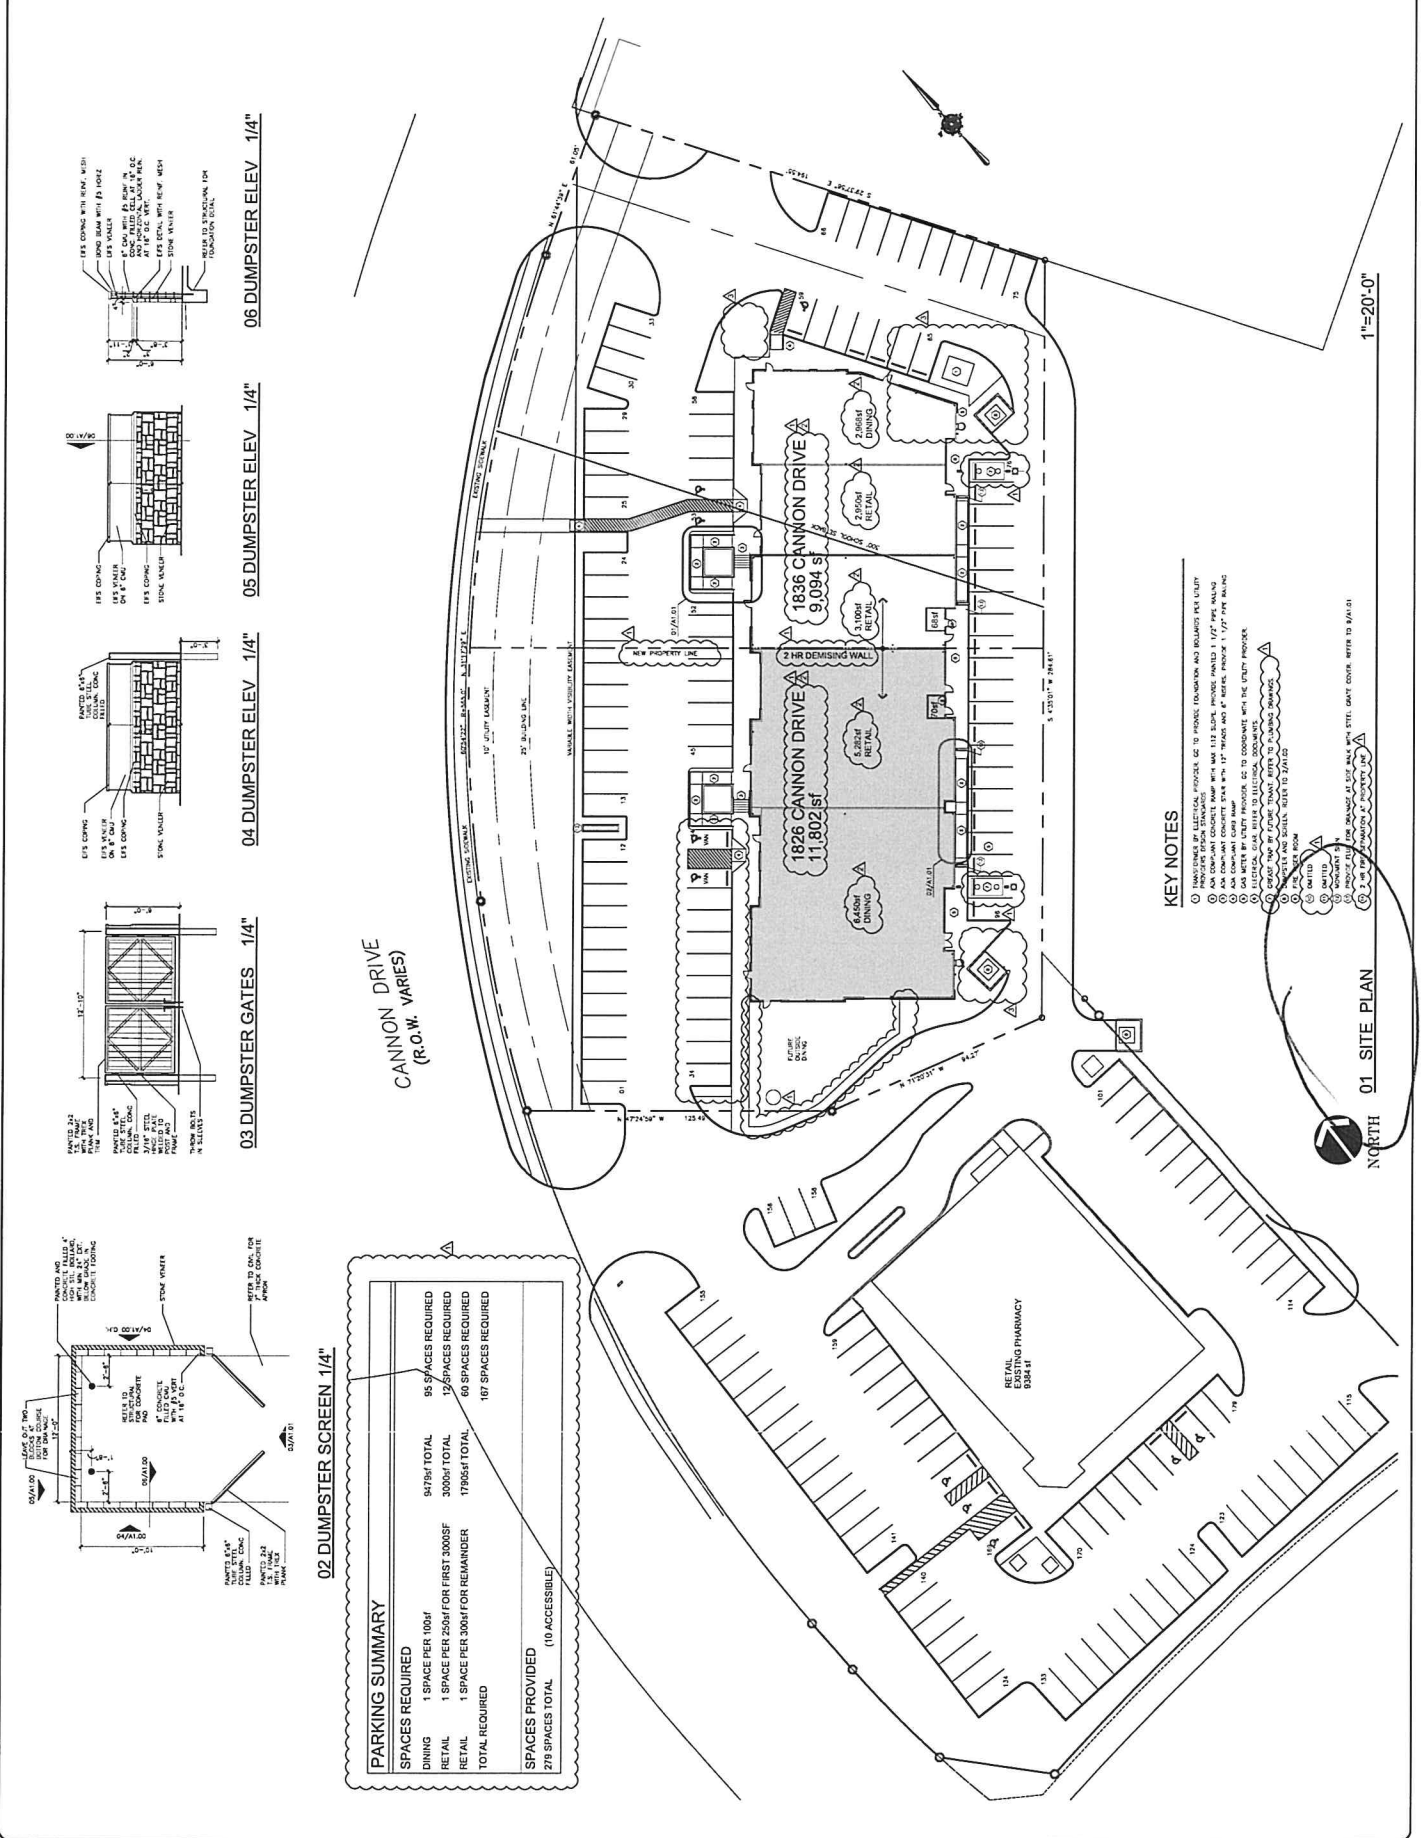

02 DUMPSTER SCREEN 1/4"

PARKING SUMMARY	
SPACES REQUIRED	
DINING	9479sf TOTAL
1 SPACE PER 100sf	
RETAIL	3000sf TOTAL
1 SPACE PER 250sf FOR FIRST 3000sf	
RETAIL	1795sf TOTAL
1 SPACE PER 300sf FOR REMAINDER	
TOTAL REQUIRED	187 SPACES REQUIRED
SPACES PROVIDED (10 ACCESSIBLE)	
278 SPACES TOTAL	

KEY NOTES

- 1. ALL UTILITIES SHOWN ARE BASED ON RECORD DRAWINGS AND FIELD SURVEY. SEE TO VERIFY LOCATION AND DEPTHS PRIOR TO CONSTRUCTION.
- 2. ALL UTILITIES SHALL BE DEPTHS SHALL BE 12" MINIMUM UNLESS OTHERWISE NOTED.
- 3. ALL UTILITIES SHALL BE 12" MINIMUM UNLESS OTHERWISE NOTED.
- 4. ALL UTILITIES SHALL BE 12" MINIMUM UNLESS OTHERWISE NOTED.
- 5. ALL UTILITIES SHALL BE 12" MINIMUM UNLESS OTHERWISE NOTED.
- 6. ALL UTILITIES SHALL BE 12" MINIMUM UNLESS OTHERWISE NOTED.
- 7. ALL UTILITIES SHALL BE 12" MINIMUM UNLESS OTHERWISE NOTED.
- 8. ALL UTILITIES SHALL BE 12" MINIMUM UNLESS OTHERWISE NOTED.
- 9. ALL UTILITIES SHALL BE 12" MINIMUM UNLESS OTHERWISE NOTED.
- 10. ALL UTILITIES SHALL BE 12" MINIMUM UNLESS OTHERWISE NOTED.

01 SITE PLAN



1"=20'-0"